

**WATER WELL DRILLERS LOG**

Date: May 5-63, 1963, Driller: Peeples Drilling Co County Clarke  
 (Name)

(1) Owner of Land: J. R. RASCOE  
 (Name)  
Stonewall, Miss  
 (Address)  
River Road 3N 1SE  
 (2) Location: 1/4, 1/4, Sec. 6 T. R.  
1/4 miles W of Stonewall  
 (distance) (direction) (Nearest Town)  
 (3) Topography: Flat  
 (Hilly) (Flat) (Level)  
 (4) Purpose of Well: Domestic  
 (Domestic Irrigation, Municipal, Industrial, Other)

Description & Color of Materials Sand, Clay, Red Clay, Shell, etc.	Thick- ness Feet	Depth Feet
<u>YELLOW SAND</u>		
<u>AND GRAVEL</u>	<u>31</u>	<u>31</u>
<u>GREEN SANDY</u>		
<u>CLAY</u>	<u>32</u>	<u>63</u>
<u>GREEN ROCK &amp;</u>		
<u>GREEN SAND</u>	<u>52</u>	<u>115</u>
<u>GREEN ROCK &amp;</u>		
<u>GREEN MARL</u>	<u>116</u>	<u>231</u>
<u>GRAY SANDY SHALE</u>	<u>21</u>	<u>252</u>
<u>WHITE COARSE SAND</u>	<u>21</u>	<u>273</u>
<u>WHITE SAND &amp;</u>		
<u>GRAY SHALE STRONG</u>	<u>42</u>	<u>315</u>


Information upon completion of well:

(1) Diameter 4 inches.  
 (2) Total Depth 315 feet.  
 (3) Water Level 760 feet below top of ground.  
 (4) Cased to 126', Size 4"  
 (5) Screen: Size NONE, Length \_\_\_\_\_  
 (6) Were any formations sealed against pollution?  
 \_\_\_\_\_ yes, \_\_\_\_\_ no.

If YES depth of formation \_\_\_\_\_

Why \_\_\_\_\_

Drillers Remarks: \_\_\_\_\_

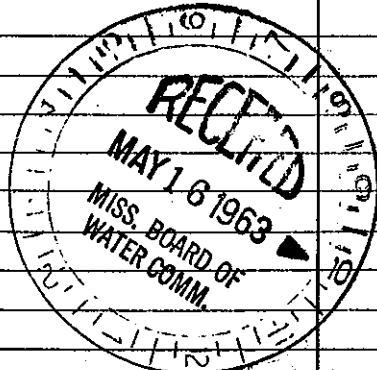

(Use Back Side)

Well No.

Mail this copy to Board of Water Commissioners 429 Miss. St. Jackson, Miss