

CLARKE

MISSISSIPPI BOARD OF WATER COMMISSIONERS

S G 56

P

6-3-63

WATER WELL DRILLERS LOG

Date: 6-3, 1963, Driller: Mc Donald Hill County Clarke  
(Name)

(1) Owner of Land	Description & Color of Materials Sand, Clay, Red Clay, Shell, etc.	Thick- ness Feet	Depth Feet
<i>William Smith</i> (Name)	<i>Clay</i>		<i>0 3</i>
(Address)	<i>Reddy Clay</i>		<i>3 54</i>
(2) Location: $\frac{1}{4}$ , $\frac{1}{4}$ , Sec. <i>2</i> <sup><i>3 N 15 E</i></sup> T. <i>R</i>	<i>Shale</i>		<i>57 87</i>
<i>3</i> miles <i>East</i> of <i>Stennis</i> (distance) (direction) (Nearest Town)	<i>lime - limey shale</i>		<i>84 95</i>
(3) Topography: <i>Hilly</i> (Hilly) (Flat) (Level)	<i>shale</i>		<i>95 108</i>
(4) Purpose of Well: <i>Domestic</i> (Domestic Irrigation Municipal, Industrial, Other)	<i>shale w/ lime streaks</i>		<i>108 142</i>
	<i>Reddy shale</i>		<i>142 147</i>
	<i>shale w/ thick lime</i>		<i>147 230</i>
	<i>Reddy shale</i>		<i>230 237</i>
	<i>Sand</i>		<i>237 275</i>
	<i>Reddy shale + sd.</i>		<i>275 280</i>


Information upon completion of well:

- (1) Diameter 3 1/4 inches.
- (2) Total Depth 280 feet.
- (3) Water Level 0 0 feet below top of ground.
- (4) Cased to 138, Size 4
- (5) Screen: Size \_\_\_\_\_, Length \_\_\_\_\_
- (6) Were any formations sealed against pollution?  
\_\_\_\_\_ yes, \_\_\_\_\_ no.

If YES depth of formation \_\_\_\_\_

Why \_\_\_\_\_

Drillers Remarks: \_\_\_\_\_

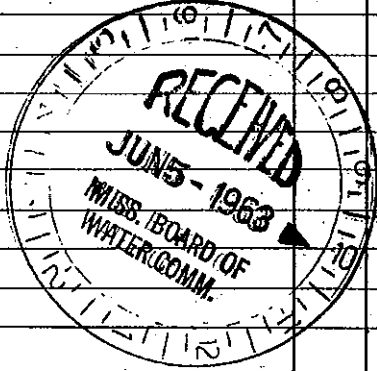

Well No.

(Use Back Side)

Mail this copy to Board of Water Commissioners 429 Miss. St. Jackson, Miss