

CLARKE MISSISSIPPI BOARD OF WATER COMMISSIONERS

5 **GG/**
3-64

WATER WELL DRILLERS LOG

Date: March, 1964, Driller: Peoples Drilling Co County Clarke
(Name)

| (1) Owner of Land: <u>Preston Adams</u> (Name) | Description & Color of Materials Sand, Clay, Red Clay, Shell, etc. | Thick- ness Feet | Depth Feet |
|---|---|------------------------|---------------|
| <u>Stonewall, Miss</u> (Address) | <u>Red Sand</u> | <u>48</u> | <u>48</u> |
| | <u>Yellow sandy clay</u> | <u>25</u> | <u>73</u> |
| (2) Location: <u>3N 15E</u> <u>1/4</u> , <u>1/4</u> , Sec. <u>1</u> T. <u>R.</u> | <u>Blue clay</u> | <u>21</u> | <u>94</u> |
| <u>4</u> miles <u>E.</u> of <u>Stonewall</u> (distance) (direction) (Nearest Town) | <u>Green sand + chert</u> | <u>21</u> | <u>115</u> |
| (3) Topography: <u>Hilly</u> (Hilly) (Flat) (Level) | <u>Blue marl + rock</u> | <u>105</u> | <u>220</u> |
| (4) Purpose of Well: <u>Domestic</u> (Domestic Irrigation Municipal, Industrial, Other) | <u>Gray shale</u> | <u>20</u> | <u>240</u> |
| | <u>White sand</u> | <u>16</u> | <u>256</u> |
| | <u>Gray shale</u> | <u>7</u> | <u>263</u> |
| | <u>White sand + small</u> | | |
| | <u>Shale streak</u> | <u>37</u> | <u>300</u> |


Information upon completion of well:

- (1) Diameter 4 inches.
- (2) Total Depth 300 feet.
- (3) Water Level 48 feet below top of ground.
- (4) Cased to 126', Size 4"
- (5) Screen: Size NONE, Length _____
- (6) Were any formations sealed against pollution?
_____ yes, _____ no.

If YES depth of formation _____

Why _____

Drillers Remarks: _____

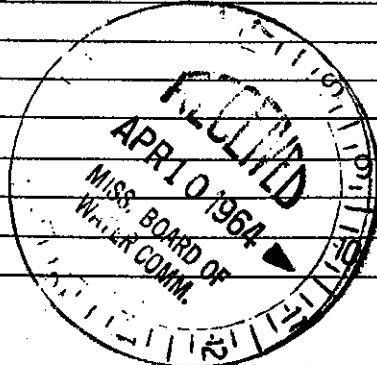

Well No. _____

Mail this copy to Board of Water Commissioners 429 Miss. St. Jackson, Miss.