

CLARKE MISSISSIPPI BOARD OF WATER COMMISSIONERS

563
4-3-64

WATER WELL DRILLERS LOG

Date: 4-3, 1964, Driller: me Donald Hill County Clarke
(Name)

	Description & Color of Materials Sand, Clay, Red Clay, Shell, etc.	Thick- ness Feet	Depth Feet
(1) Owner of Land: <u>DEAN CAWAT</u> (Name)	<u>Clay</u>	0	0
<u>M. # 1, Outway miss.</u> (Address)	<u>Sand</u>	5	83
(2) Location: <u>3/4</u> , <u>3/4</u> , Sec. <u>1</u> T. <u>R.</u>	<u>Shale</u>	83	100
<u>4</u> miles <u>E</u> , of <u>Shiloh</u> (distance) (direction) (Nearest Town)	<u>limy shale & lime</u>	100	107
(3) Topography: <u>Hilly</u> (Hilly) (Flat) (Level)	<u>Sandy shale</u>	107	115
(4) Purpose of Well: <u>Domestic</u> (Domestic Irrigation Municipal, Industrial, Other)	<u>shale w/ lime st.</u>	115	232
	<u>Sandy shale</u>	232	242
	<u>Sand w/ some red</u>	242	270
	<u>and blue shale</u>		
	<u>strata</u>		


Information upon completion of well:

- (1) Diameter 4 inches.
- (2) Total Depth 270 feet.
- (3) Water Level 76 feet below top of ground.
- (4) Cased to 126, Size 4
- (5) Screen: Size _____, Length _____
- (6) Were any formations sealed against pollution?
_____ yes, _____ no.

If YES depth of formation _____

Why _____

Drillers Remarks: _____

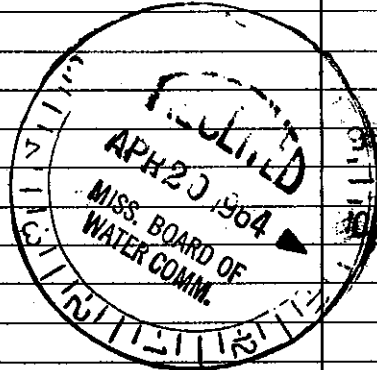

(Use Back Side)

Well No.

Mail this copy to Board of Water Commissioners 429 Miss. St. Jackson, Miss.