


CLARKE MISSISSIPPI BOARD OF WATER COMMISSIONERS

G 64  
1-21-64

WATER WELL DRILLERS LOG

Date: 1-21, 1964, Driller: McDonald & Hill County Clarke  
(Name)

(1) Owner of Land: <u>Jeff Green</u> (Name)	Description & Color of Materials Sand, Clay, Red Clay, Shell, etc.	Thick- ness Feet	Depth Feet
<u>Rt #1, Quitman Miss</u> (Address)	<u>Clay</u>	<u>0</u>	<u>22</u>
(2) Location: <u>3/4</u> , <u>3/4</u> , Sec. <u>1</u> T. <u>R.</u>	<u>sand &amp; sandy clay</u>	<u>22</u>	<u>40</u>
<u>4</u> miles <u>E</u> , of <u>Altamona</u> (distance) (direction) (Nearest Town)	<u>sand</u>	<u>40</u>	<u>110</u>
(3) Topography: <u>Hilly</u> (Hilly) (Flat) (Level)	<u>shale</u>	<u>110</u>	<u>120</u>
(4) Purpose of Well: <u>Domestic</u> (Domestic Irrigation Municipal, Industrial, Other)	<u>finer shales</u>	<u>120</u>	<u>140</u>
Information upon completion of well:	<u>sandy shale &amp; sand</u>	<u>140</u>	<u>100</u>
(1) Diameter <u>4</u> inches.	<u>shale w/ lignite str</u>	<u>100</u>	<u>264</u>
(2) Total Depth <u>320</u> feet.	<u>sand</u>	<u>264</u>	<u>266</u>
(3) Water Level <u>70</u> feet below top of ground.	<u>sandy shale &amp; shale</u>	<u>266</u>	<u>276</u>
(4) Cased to <u>163</u> , Size <u>4</u>	<u>red shale</u>	<u>276</u>	<u>280</u>
(5) Screen: Size _____, Length _____	<u>coarse sand</u>	<u>280</u>	<u>298</u>
(6) Were any formations sealed against pollution? _____ yes, _____ no.	<u>sandy shale</u>	<u>298</u>	<u>303</u>
If YES depth of formation _____	<u>sand</u>	<u>303</u>	<u>308</u>
Why _____	<u>sand - sandy shale</u>	<u>308</u>	<u>320</u>
Drillers Remarks: <u>Lost Circulation</u>			
<u>@ 67'</u>			

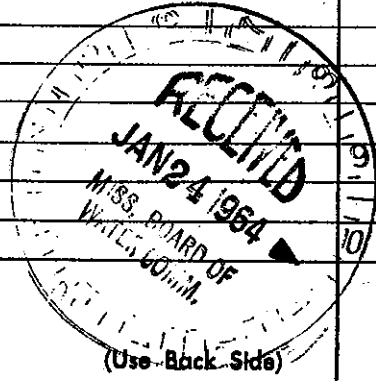

Well No.

Mail this copy to Board of Water Commissioners 429 Miss. St. Jackson, Miss.