

CLARKE

665

12-5-63


MISSISSIPPI BOARD OF WATER COMMISSIONERS

WATER WELL DRILLERS LOG

Date: 12-5, 1963, Driller: McDaniel Hill County Clarke

(Name)

(1) Owner of Land: <u>Reuben Green</u> (Name)	Description & Color of Materials Sand, Clay, Red Clay, Shell, etc.	Thick- ness Feet	Depth Feet
(Address)	sandy clay	0	20
(2) Location: <u>3N15E</u> <u>2</u> $\frac{1}{4}$, <u>2</u> $\frac{1}{4}$, Sec. <u>2</u> T. <u>R.</u>	sand	20	63
<u>5</u> miles <u>E</u> , of <u>Stone</u> (distance) (direction) (Nearest Town)	shale	63	87
(3) Topography: <u>Hilly</u> (Hilly) (Flat) (Level)	shale & sand lime	87	100
(4) Purpose of Well: <u>Domestic</u> (Domestic Irrigation Municipal, Industrial, Other)	Hard sandy shale	100	117
Information upon completion of well:	shale w/ lime streaks	117	145
(1) Diameter <u>$3\frac{7}{8}$</u> inches.	sand	145	146
(2) Total Depth <u>300</u> feet.	shale w/ lime streaks	146	170
(3) Water Level <u>12</u> feet below top of ground.	sand w/ lime streaks	170	175
(4) Cased to <u>184</u> , Size <u>4</u>	shale w/ lime streaks	175	235
(5) Screen: Size _____, Length _____	shale	235	257
(6) Were any formations sealed against pollution? _____ yes, _____ no.	sand w/ shale streaks	257	270
If YES depth of formation _____	Coarse sand	270	285
Why _____	shale	285	290
Drillers Remarks: _____	sandy shale	290	300

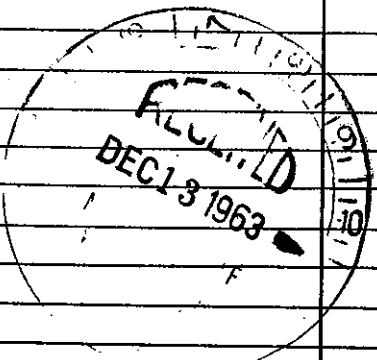

Well No.

(Use Back Side)

Mail this copy to Board of Water Commissioners 429 Miss. St. Jackson, Miss