

CLARKE MISSISSIPPI BOARD OF WATER COMMISSIONERS

WATER WELL DRILLERS LOG

5 G 68
5-62

Date: May, 1962, Driller: Peeples & Rutledge County Clarke
(Name)

	Description & Color of Materials Sand, Clay, Red Clay, Shell, etc.	Thick- ness Feet	Depth Feet
(1) Owner of Land: <u>E. F. Page</u> (Name)	Top soil to yellow		
<u>Rt. 1, Quitman, Miss.</u> (Address)	sand + small clay streak	137	137
(2) Location: <u>1/4</u> , <u>1/4</u> , Sec. <u>13</u> <u>3N 15E</u> T. R.	Dark gray sandy shale	13	150
<u>4</u> miles <u>North</u> of <u>Quitman</u> (distance) (direction) (Nearest Town)	Rock	18	168
(3) Topography: <u>Hilly</u> (Hilly) (Flat) (Level)	Gray sandy shale	10	178
(4) Purpose of Well: <u>Domestic</u> (Domestic Irrigation Municipal, Industrial, Other)	Rock + small shale		
	streaks	95	273
	soft green & white		
	lime & limestone	21	294
	gray soft sandy shale		
	& small white sand like	53	347


Information upon completion of well:

- (1) Diameter 4 inches.
- (2) Total Depth 347 feet.
- (3) Water Level 35 feet below top of ground.
- (4) Cased to 182, Size 4"
- (5) Screen: Size None, Length _____
- (6) Were any formations sealed against pollution?
 yes, _____ no.

If YES depth of formation 137'

Why High iron content.

Drillers Remarks: _____

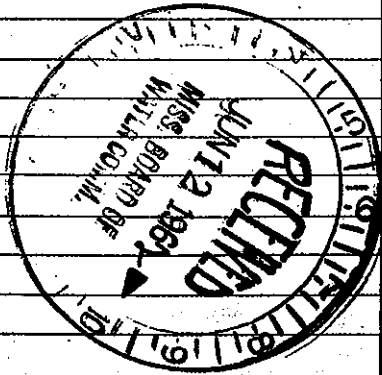

(Use Back Side)

Well No.

Mail this copy to Board of Water Commissioners 429 Miss. St. Jackson, Miss.