

CLARKE MISSISSIPPI BOARD OF WATER COMMISSIONERS

5 G 69

G 301


WATER WELL DRILLERS LOG

Date: 7-6, 1960, Driller: Peoples of Rutledge County, Clarke
(Name)

(1) Owner of Land: <u>A. T. Lindsey</u> (Name)	Description & Color of Materials Sand, Clay, Red Clay, Shell, etc.	Thick- ness Feet	Depth Feet
<u>45 North - Quitman Miss</u> (Address)	<u>Red Sandy Clay</u>	<u>12</u>	<u>12</u>
(2) Location: <u>3/4</u> , <u>3/4</u> , Sec <u>23</u> ^{3N 15E} T. R.	<u>Yellow " "</u>	<u>31</u>	<u>43</u>
<u>3</u> miles <u>North</u> of <u>Quitman</u> (distance) (direction) (Nearest Town)	<u>Sandy Shale</u>	<u>53</u>	<u>94</u>
(3) Topography: <u>Hilly</u> (Hilly) (Flat) (Level)	<u>Light Rock & Sand</u>	<u>123</u>	<u>168</u>
(4) Purpose of Well: <u>Domestic</u> (Domestic Irrigation Municipal, Industrial, Other)	<u>Green Sandy Shale</u>	<u>17</u>	<u>185</u>
	<u>Sand White</u>	<u>31</u>	<u>216</u>

Information upon completion of well:

- (1) Diameter 2 inches.
- (2) Total Depth 216 feet.
- (3) Water Level 84 feet below top of ground.
- (4) Cased to 210, Size 2"
- (5) Screen: Size 2, Length 6
- (6) Were any formations sealed against pollution?
_____ yes, _____ no.

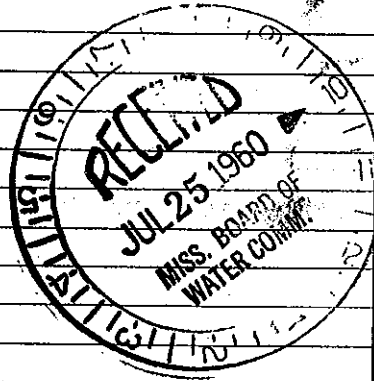

If YES depth of formation _____

Why _____

Drillers Remarks: _____

(Use Back Side)

Mail this copy to Board of Water Commissioners 429 Miss. St. Jackson

Wells