

CLARKE

MISSISSIPPI BOARD OF WATER COMMISSIONERS

G 70

7-16-62

WATER WELL DRILLERS LOG

Date: 7-16, 1962, Driller: M. E. Donald & H. H. Inc. County: Clarke

(Name)

(1) Owner of Land: James Moore (Name)

Rt. # 1, Quitman, Miss (Address)

(2) Location: 1/4, 1/4, Sec. 24 3N 5E T. R.

3 miles north of Quitman (distance, direction, Nearest Town)

(3) Topography: (Hilly) (Flat) (Level)

(4) Purpose of Well: Domestic (Domestic Irrigation, Municipal, Industrial, Other)

Description & Color of Materials Sand, Clay, Red Clay, Shell, etc.

Thick-ness Feet

Depth Feet

Clay	0	18
Sand	18	40
Shale & st. Lime	40	105
Shale	105	130
Brown Shale & Lignite	130	180
Sand	180	190
Fine Sand	190	210
Sand #12-14	210	225

Information upon completion of well:

(1) Diameter: 3 inches.

(2) Total Depth: 225 feet.

(3) Water Level: 80 feet below top of ground.

(4) Cased to: 126, Size: 3

(5) Screen: Size: none, Length:


(6) Were any formations sealed against pollution?

yes, no.

If YES depth of formation:

Why:

Drillers Remarks:

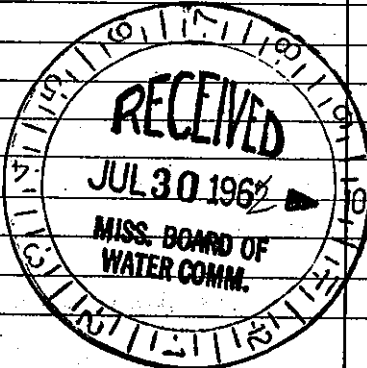

(Use Back Side)

Well No.

Mail this copy to Board of Water Commissioners 429 Miss. St. Jackson, Miss