

CLARKE MISSISSIPPI BOARD OF WATER COMMISSIONERS

6 G 71

3-20-63

WATER WELL DRILLERS LOG

Date: 3-20, 1963, Driller: M. Donald Hill, Jr. County Clay

(Name)

(1) Owner of Land: Robert E. Lee
 (Name)
Rt #1, Quitman, Miss
 (Address)

(2) Location: 3/4, 1/4, Sec. 1 3N15E
 T. R.

6 miles N of Quitman
 (distance) (direction) (Nearest Town)

(3) Topography: (Hilly) (Flat) (Level)

(4) Purpose of Well: Domestic
 (Domestic Irrigation, Municipal, Industrial, Other)

Description & Color of Materials Sand, Clay, Red Clay, Shell, etc.	Thick- ness Feet	De. Feet
Clay	0	10
Sand	10	20
B. Shale	20	40
Hard lime & shale	40	55
Sandy shale	55	60
Hard lime & shale	60	65
med. shale & lime st.	65	90
Lime & shale st.	90	95
med shale & lime st.	95	105
Sand flint & shale	105	172
Hard sandy shale	172	180
Sand #12	180	215

Information upon completion of well:

(1) Diameter 4" inches.

(2) Total Depth 220' feet.

(3) Water Level 18' feet below top of ground.

(4) Cased to 91', Size 4


(5) Screen: Size none, Length _____

(6) Were any formations sealed against pollution?
 _____ yes, no.

If YES depth of formation _____

Why _____

Drillers Remarks: _____

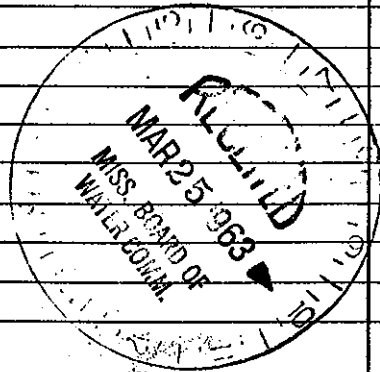

(Use Back Side)

Well No.

Mail this copy to Board of Water Commissioners 429 Miss. St. Jackson, Miss