

CLARKE

MISSISSIPPI BOARD OF WATER COMMISSIONERS

P

6 G72

3-3-66

WATER WELL DRILLERS LOG

Date: 3, 3, 1966, Driller: M. McDonald & Hill County, CLARKE

(Name)

(1) Owner of Land: MONROE MASON  
 (Name)  
STONE WALL MISS  
 (Address)

(2) Location: 3/4, 3/4, Sec. 9 T. R.  
5 miles N.W., of Quincy  
 (distance) (direction) (Nearest Town)

(3) Topography: X  
 (Hilly) (Flat) (Level)

(4) Purpose of Well: DOMESTIC  
 (Domestic Irrigation  
 Municipal, Industrial, Other)

Description & Color of Materials Sand, Clay, Red Clay, Shell, etc.	Thick- ness Feet	Depth Feet
RED CLAY	0	16
YELLOW CLAY SAND	16	75'
SHALE	75	135
SHALE ST ROCK	135	180
SAND	180	185
SHALE ST ROCK	185	267
SAND	267	290

Information upon completion of well:

(1) Diameter 3 1/8 TEST HOLE inches.


(2) Total Depth 290' feet.

(3) Water Level 40' feet below top of ground.

(4) Cased to 120', Size 4"

(5) Screen: Size \_\_\_\_\_, Length \_\_\_\_\_

(6) Were any formations sealed against pollution?  
 \_\_\_\_\_ yes, X no.

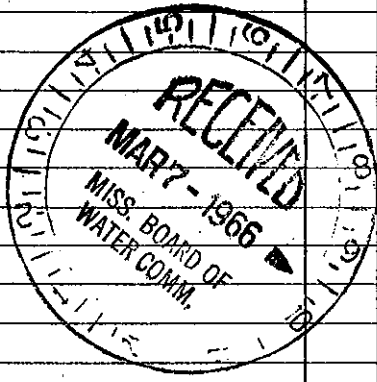

If YES depth of formation \_\_\_\_\_

Why \_\_\_\_\_

Drillers Remarks: \_\_\_\_\_

Well No.

(Use Back Side)

Mail this copy to Board of Water Commissioners 429 Miss. St. Jackson, Miss