

MISSISSIPPI
BOARD OF WATER COMMISSIONERS
416 North State Street
Jackson, Mississippi 39201

INDEXED

WATER WELL DRILLERS LOG

Clarke
G78
4-26-68
GW 2471
9-26-68

1968 Layne-Central Company Clarke
date well completed firm name county well located

LANDOWNER:
Town of Stonewall
Stonewall, Miss
(mailing address)


WELL LOCATION:
sec. 5 T. 3 N R. 15 E
S W
(distance) miles (direction) of (nearest town)

WELL PURPOSE: Municipal
(home, irrigation, municipal, industrial)

WELL COMPLETION DATA:
(1) diameter (inches) 12"
(2) total depth (feet) 416'
static water level (feet) Flow below above top of ground.
(4) casing Steel, 368'
(material) (depth)
12" if telescope see back.
(size)
(5) screen 40', 370'
(length) (depth to top)
6", Stainless Steel
(size) (material)
(6) pump 15 (HP) (yield gpm)
Electric
(type power)
(7) electric log NO
(yes or no)
(organization running log)
(8) how well bottom plugged Valve

description of formations encountered	from to	
<u>Top Soil</u>	<u>0</u>	<u>5</u>
<u>Loose Sand</u>	<u>5</u>	<u>18</u>
<u>Black Clay & Rock / Struck</u>	<u>18</u>	<u>62</u>
<u>Rock</u>	<u>62</u>	<u>72</u>
<u>Shale and Rock / Struck</u>	<u>72</u>	<u>195</u>
<u>Hard Shale</u>	<u>195</u>	<u>218</u>
<u>Sand and Shale / Struck</u>	<u>218</u>	<u>260</u>
<u>Hard Shale</u>	<u>260</u>	<u>337</u>
<u>Hard Rock</u>	<u>337</u>	<u>342</u>
<u>Shale, Iron Scale & Lignite</u>	<u>342</u>	<u>367</u>
<u>Fine Sand</u>	<u>367</u>	<u>412</u>
<u>Humming Shale</u>	<u>412</u>	<u>428</u>

INDEXED

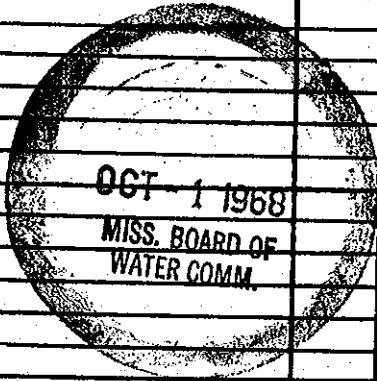

DRILLERS REMARKS:
Pump not installed as of this date -