

Clarke
G79
8-16-68

MISSISSIPPI
 BOARD OF WATER COMMISSIONERS **SEED**
 416 North State Street
 Jackson, Mississippi 39201

WATER WELL DRILLERS LOG

8-16-1968 *Williamson Drilling Co. Clark*
 date well completed firm name county well located


LANDOWNER: <i>Alvester Jacobs</i> <i>Pt 1 Bal 92 Quintana</i> (mailing address)	description of formations encountered	from	to
	<i>top soil</i>	<i>0</i>	<i>2</i>
	<i>Red Clay</i>	<i>2</i>	<i>6</i>
	<i>Blue Clay</i>	<i>6</i>	<i>40</i>
	<i>sand</i>	<i>40</i>	<i>70</i>
	<i>Blue Clay</i>	<i>90</i>	<i>115</i>
	<i>shell</i>	<i>115</i>	<i>225</i>
	<i>fractured sand & clay</i>	<i>225</i>	<i>296</i>

WELL LOCATION:
 sec. *24* T. *3* (N) R. *15* (E)
3 miles *North* of *Quintana*
 (distance) (direction) (nearest town)

WELL PURPOSE: *Home*
 (home, irrigation, municipal, industrial)

- WELL COMPLETION DATA:
- (1) diameter (inches) *4"*
 - (2) total depth (feet) *296*
 - (3) static water level (feet) *flow* ^{below} _{above} top of ground
 - (4) casing *Black* *97'*
 (material) (depth)
 - 4"* If telescope see back.
 (size)
 - (5) screen *no*
 (length) (depth to top)
 - (size) (material)
 - (6) pump *1/2* *7*
 (HP) (yield gpm)
 - Electric*
 (type power)
 - (7) electric log *no*
 (yes or no)
 - no*
 (organization running log)
 - (8) how well bottom plugged *open*

CODED

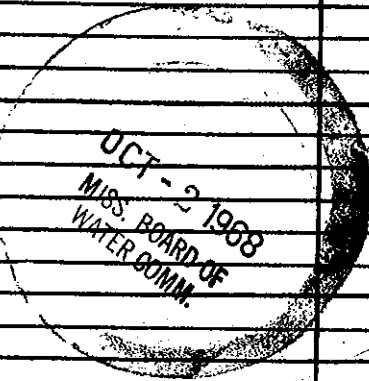

DRILLERS REMARKS: