

Seg. 1.

Clarke
G 80
8-9-68

MISSISSIPPI
BOARD OF WATER COMMISSIONERS
476 North State Street
Jackson, Mississippi 39201

TELETYPE
CODED

WATER WELL DRILLERS LOG

8-9-1968 date well completed
1968 Wilkinson Drilling Co. firm name
Clarke county well located


LANDOWNER: Curtis Rott
Stone Wall Invis
(mailing address)
WELL LOCATION:
sec. 5 T. 30 N. R. 15 E
inside City Stone Wall
(distance) (direction) (nearest town)

description of formations encountered	from	to
Red Clay	0	10
sand	10	80
Blue Clay	80	110
shell	110	275
sand	275	310

WELL PURPOSE: Home
(home, irrigation, municipal, industrial)

- WELL COMPLETION DATA:
- (1) diameter (inches) 4
 - (2) total depth (feet) 310
 - (3) static water level (feet) 110 ^{below}/_{above} top of ground.
 - (4) casing Black 96
(material) (depth)
4 If telescope see back.
(size)
 - (5) screen 70
(length) (depth to top)
(size) (material)
 - (6) pump 1/2 5
(HP) (yield gpm)
Elect
(type power)
 - (7) electric log No
(yes or no)
No
(organization running log)
 - (8) how well bottom plugged open

CODED

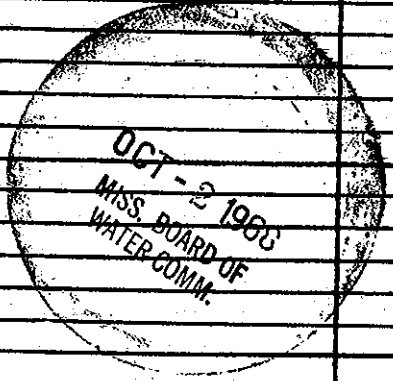

DRILLERS REMARKS: