

3 13P

320750N 0984720

Seg. 2

FEW

Clarke
G81
8-6-68

MISSISSIPPI
 BOARD OF WATER COMMISSIONERS
 416 North State Street
 Jackson, Mississippi 39201

CODED

WATER WELL DRILLERS LOG

8-6-1968 William Drilling Co. Clay
 date well completed firm name county well located

LANDOWNER: H.C. Moffett
Stonewall, Miss.
 (mailing address)

description of formations encountered

from to

<u>Blue Clay</u>	<u>0</u>	<u>35</u>
<u>sand</u>	<u>35</u>	<u>90</u>
<u>Blue Clay</u>	<u>90</u>	<u>110</u>
<u>shale</u>	<u>110</u>	<u>150</u>
<u>hard</u>	<u>150</u>	<u>196</u>


WELL LOCATION:
 sec. 5 T. 3 N R. 15 E
inside miles City Stonewall
 (distance) (direction) (nearest town)

WELL PURPOSE: Home
 (home, irrigation, municipal, industrial)

WELL COMPLETION DATA:

- (1) diameter (inches) 1 1/2
- (2) total depth (feet) 196
- (3) static water level (feet) 38 below above top of ground.
- (4) casing Black 87
 (material) (depth)
4 If telescope see back.
 (size)
- (5) screen 20
 (length) (depth to top)
 (size) (material)
- (6) pump 1/2 6
 (HP) (yield gpm)
Electric
 (type power)
- (7) electric log No
 (yes or no)
No
 (organization running log)
- (8) how well bottom plugged open

CODED

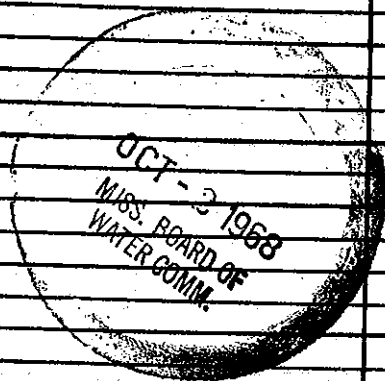

DRILLERS REMARKS: