

Clarke

MISSISSIPPI BOARD OF WATER COMMISSIONERS

G 96

WATER WELL DRILLERS LOG

7-2-65

Date: July 2, 1965, Driller: McDonald + Heil County: Clarke

CODED

(1) Owner of Land: Lee J. Jeddie
 (Name)
 Stonewall, Miss
 (Address)
 9 3N/5E
 (2) Location: 1/4, 1/4, Sec. T R
 2 miles East of Quitman
 (distance) (direction) (Nearest Town)
 (3) Topography: Hilly
 (Hilly) (Flat) (Level)
 (4) Purpose of Well: Domestic
 (Domestic Irrigation
 Municipal, Industrial, Other)


Description & Color of Materials Sand, Clay, Red Clay, Shell, etc.	Thick- ness Feet	Depth Feet
Clay + Sand	0	75
Med. Sand	75	90

Information upon completion of well:

(1) Diameter 2 inches.
 (2) Total Depth 90 feet.
 (3) Water Level 40 feet below top of ground.
 (4) Cased to 90, Size 2
 (5) Screen: Size 2, Length 4
 (6) Were any formations sealed against pollution?
 yes, no. no.

If YES depth of formation _____
 Why _____
 Drillers Remarks: _____

CODED

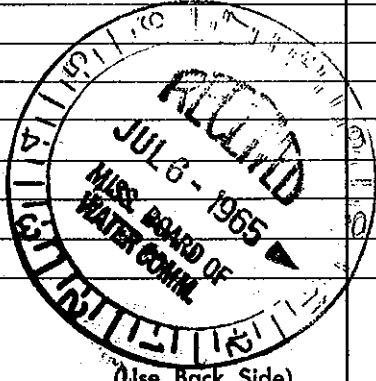

Well No.

Mail this copy to Board of Water Commissioners 429 Miss. St. Jackson, Miss