

Clarke
G 98
11-21-63

MISSISSIPPI BOARD OF WATER COMMISSIONERS

WATER WELL DRILLERS LOG

MCDONALD & HILL, INC.

Date: 11-21, 1963, Driller: P. O. Box 81, Meridian, Mississippi

CODED

(1) Owner of Land: <u>H.E. Mustard</u> (Name)	Description & Color of Materials Sand, Clay, Red Clay, Shell, etc.	Thick- ness Feet	Depth Feet
<u>Quitman, Miss.</u> (Address)	Clay	6	18
(2) Location: <u>23 3N/5E</u> <u>3</u> miles <u>N</u> of <u>Quitman</u> (distance) (direction) (Nearest Town)	Sand	18	95
(3) Topography: <u>Flat</u> (Hilly) (Flat) (Level)	Med Shale	95	130
(4) Purpose of Well: <u>Domestic</u> (Domestic Irrigation Municipal, Industrial, Other)	Shale	130	138
	Sand	138	160
	Sandy Shale	160	257
	Med. Shale	257	266
	Sandy Shale	266	285
	fine Sand	285	310
	Sandy Shale	310	330
	#12 Sand	330	340

Information upon completion of well:


- (1) Diameter 3 inches.
- (2) Total Depth 340 feet.
- (3) Water Level 14 feet below top of ground.
- (4) Cased to 168, Size 3.
- (5) Screen: Size _____, Length _____.
- (6) Were any formations sealed against pollution?
_____ yes, no.

If YES, depth of formation _____

Why _____

Drillers Remarks: _____

CODED

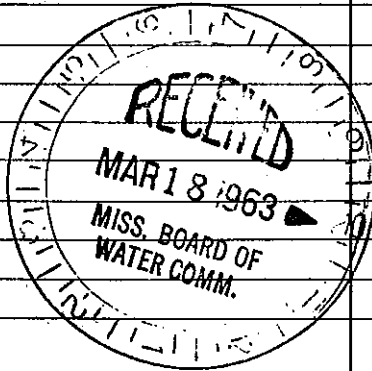

Well No.

(Use Back Side)

Mail this copy to Board of Water Commissioners 429 Miss. St. Jackson, Miss.