

Clarke
G-99

MISSISSIPPI BOARD OF WATER COMMISSIONERS

WATER WELL DRILLERS LOG

7-31-62

Date: 7-31, 1962, Driller McDonald & Hill

(Name)


COPIED

(1) Owner of Land	Description & Color of Materials Sand, Clay, Red Clay, Shell, etc.	Thick- ness Feet	Depth Feet
Oscar Mc Lendon (Name)	Sandy Clay	0	45
Rt #1 Quitman (Address)	Shale	45	60
(2) Location: <u>26 3N15E</u> 1/4, 1/4, Sec. T R	Sandy Shale	60	70
<u>2</u> miles <u>North</u> of <u>Quitman</u> (distance) (direction) (Nearest Town)	H. Shale	70	105
(3) Topography: <input checked="" type="checkbox"/> (Hilly) <input type="checkbox"/> (Flat) <input type="checkbox"/> (Level)	Soft Shale	105	115
(4) Purpose of Well: <u>Domestic</u> (Domestic Irrigation Municipal, Industrial, Other)	Lime	115	120
	Sandy Lime	120	163
	Shale	163	167
	Sandy	167	171
	Lime & Sand	171	196
	Co Sand	196	220

Information upon completion of well:

- (1) Diameter 2 inches.
- (2) Total Depth 220 feet.
- (3) Water Level 90 feet below top of ground.
- (4) Cased to 210, Size 2"
- (5) Screen: Size 2" #12, Length 5
- (6) Were any formations sealed against pollution?
 yes, no.

COPIED

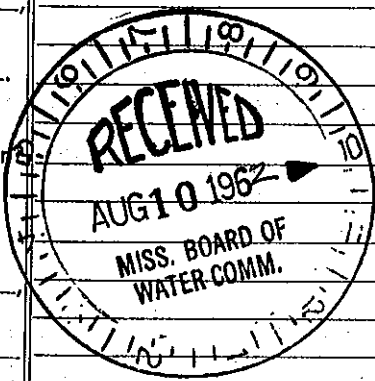

If YES depth of formation _____

Why _____

Drillers Remarks: _____

Well No.

(Use Back Side)

Mail this copy to Board of Water Commissioners 429 Miss. St. Jackson, Miss