


Clarke
G 110
7-67

MISSISSIPPI
BOARD OF WATER COMMISSIONER
416 North State Street
Jackson, Mississippi 39201

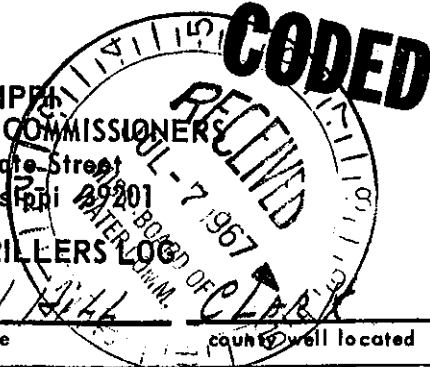

WATER WELL DRILLERS LOG

7.5.1967 1967 McDonald Hill Clarke
date well completed firm name county well located

LANDOWNER: T.C. CARTER
QUITMAN

description of formations encountered	from	to
CLAY	0	10
Sand & Clay	10	40
Shale	40	55
Shale	55	110
Sandy Lime & Rock	110	140
Shale	140	165
Sand	165	172
Shale	172	180
Sandy	180	195
Sand	195	220

(mailing address)
WELL LOCATION:
sec. 26 T. 30 S. R. 15 E.
1 1/2 miles NW of QUITMAN
(distance) (direction) (nearest town)

WELL PURPOSE:
(home, irrigation, municipal, industrial)

- WELL COMPLETION DATA:
- (1) diameter (inches) 4" WELL
 - (2) total depth (feet) 220'
 - (3) static water level (feet) 64' below top of ground.
 - (4) casing BLACK, 147' (material) (depth)
4" (size) If telescope see back.
 - (5) screen NO, NO (length) (depth to top)
NO, NO (size) (material)
 - (6) pump K&H JET 16 (HP) (yield gpm)
220 (type power)
 - (7) electric log NO (yes or no)
NO (organization running log)
 - (8) how well bottom plugged OPEN

CODED

DRILLERS REMARKS: