


CLARK  
 G 2000  
 4-1-76

MISSISSIPPI  
 BOARD OF WATER COMMISSIONERS  
 416 North State Street  
 Jackson, Mississippi 39201

WATER WELL DRILLERS LOG

4-1-76 13P McDONALD HILL CLARK  
 date well completed firm name county well located

LANDOWNER:	description of formations encountered	from	to
Ralph Irby	Clay sand	0	18
STONEWALL (mailing address)	yellow sand	18	55
WELL LOCATION: sec. 12 T 3 N R 15 E S W	sand	55	79
3 MILES WEST CLARK PARK (distance) (direction) (nearest town)	Rock	79	85
WELL PURPOSE: Home (home, irrigation, municipal, industrial)	Rock & shale	85	110
WELL COMPLETION DATA: (1) diameter (inches) 4"	Rock & shale	110	230
(2) total depth (feet) 280	sand	230	280
(3) static water level (feet) 39' below top of ground.			
(4) casing PVC 74' (material) (depth)			
(size) If telescope see back.			
(5) screen (length) (depth to top)			
(size) (material)			
(6) pump 1/2 sub 10 (HP) (yield gpm)			
(type power) E			
(7) electric log (yes or no)			
(organization running log)			
(8) how well bottom plugged OPEN			
DRILLERS REMARKS:			

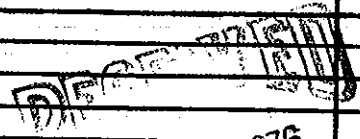

MAY 3 1976

MISS. BD. OF WATER COMM.