


CLARKE

6 G H 5
11-9-64

WATER WELL DRILLERS LOG

Date: 11-9, 1964, Driller: M^e Donald d. Hill, Jr. County: CLARKE
(Name)

(1) Owner of Land	Description & Color of Materials Sand, Clay, Red Clay, Shell, etc.	Thick- ness Feet	Depth Feet
POFUS NC CREE (Name)	CLAY	0	20
QUITMAN (Address)	SANDY CLAY	20	40
Location: 1/4, 1/4, Sec. 7 T R, 3N 16E	SHAPE	40	170
5 miles NORTH of (distance) (direction) (Nearest Town)	BROWN SHAPE & SAND	170	190
(3) Topography: X (Hilly) (Flat) (Level)	SAND	190	220
(4) Purpose of Well: DOMESTIC (Domestic Irrigation Municipal, Industrial, Other)			
Information upon completion of well:			
(1) Diameter 4" WELL inches.			
(2) Total Depth 220' feet.			
(3) Water Level 88' feet below top of ground.			
(4) Cased to 160', Size 4" BLACK			
(5) Screen: Size _____, Length _____.			
(6) Were any formations sealed against pollution? _____ yes, _____ no.			
If YES depth of formation _____			
Why _____			
Drillers Remarks: _____			

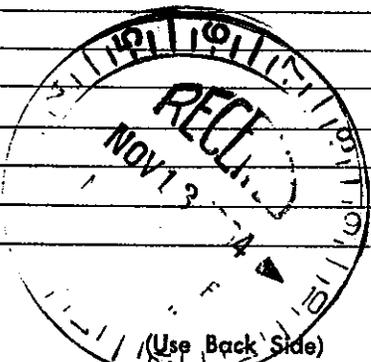

Well No.