

Clarke  
3 H7  
6-67

MISSISSIPPI  
 BOARD OF WATER COMMISSIONERS  
 416 North State Street  
 Jackson, Mississippi 39201

WATER WELL DRILLERS LOG


6-19 1967 McDONALD HILL CLARKE  
 date well completed firm name county well located

LANDOWNER:	description of formations encountered	from	to
<u>JOHNNY LEE DEARMAN</u>			
<u>QUITMAN MISS</u> (mailing address)	<u>hard</u>	<u>0</u>	<u>85</u>
	<u>big sand</u>	<u>85</u>	<u>97</u>
	<u>Shale</u>	<u>97</u>	<u>112</u>
	<u>Thin Shale Bed</u>	<u>112</u>	<u>152</u>
	<u>SANDY</u>	<u>152</u>	<u>155</u>
	<u>Thin Sand Bed</u>	<u>155</u>	<u>252</u>
	<u>Bluish Shale</u>	<u>252</u>	<u>261</u>
	<u>SAND M</u>	<u>261</u>	<u>280</u>
	<u>G SAND No 10-12</u>	<u>280</u>	<u>290</u>
	<u>SAND SHALE STR</u>	<u>290</u>	<u>296</u>
	<u>SHALE</u>	<u>296</u>	<u>300</u>

WELL LOCATION:  
 sec 6 T 3 N R 16 E  
 S W  
6 miles N of QUITMAN  
 (distance) (direction) (nearest town)

WELL PURPOSE: HOME  
 (home, irrigation, municipal, industrial)

- WELL COMPLETION DATA:
- (1) diameter (inches) 4
  - (2) total depth (feet) 300
  - (3) static water level (feet) 110 below above top of ground.
  - (4) casing BLK 173  
 (material) (depth)  
4 if telescope see back.  
 (size)
  - (5) screen \_\_\_\_\_  
 (length) (depth to top)  
 (size) (material)
  - (6) pump 34 10  
 (HP) (yield gpm)  
220  
 (type power)
  - (7) electric log NO  
 (yes or no)  
NO  
 (organization running log)
  - (8) how well bottom plugged OPEN

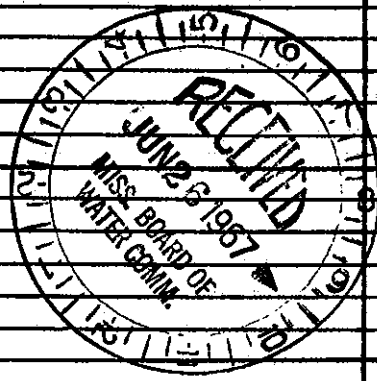

DRILLERS REMARKS: