

Clarke
3 H 9
1-68

MISSISSIPPI
BOARD OF WATER COMMISSIONERS
416 North State Street
Jackson, Mississippi 39201

WATER WELL DRILLERS LOG

Jan 19 68 Peoples Drilling Co Clarke
date well completed firm name county well located

LANDOWNER: F. Lloyd McCama

R 22

description of formations encountered

from to

Red clay

0 8

Quitman, Miss
(mailing address)

Grey shale

8 38

WELL LOCATION:

sec. 33 T 30 N R 16 E

Grey sand
shaly sand

38 55

4 miles E of Quitman
(distance) (direction) (nearest town)

Green limy shale

55 84

WELL PURPOSE: Home
(home, irrigation, municipal, industrial)

limst limestone

84 168

WELL COMPLETION DATA:

(1) diameter (inches) 4
(2) total depth (feet) 279
(3) static water level (feet) 134 below top of ground.

Brown sandy shale + small sand streaks

168 215

(4) casing Iron 210'
(material) (depth)

White sand

215 279

4" If telescope see back.
(size)

(5) screen 6' 273
(length) (depth to top)

2" Brass
(size) (material)


(6) pump 1/2 12
(HP) (yield gpm)

elect
(type power)

(7) electric log No
(yes or no)

(organization running log)

(8) how well bottom plugged Back
wash valve

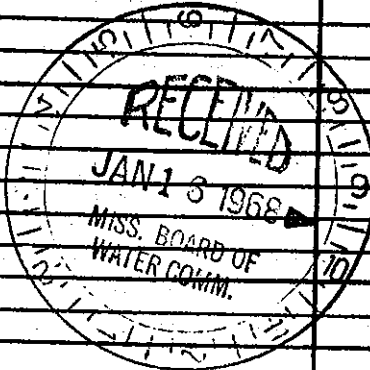

DRILLERS REMARKS: