

MISSISSIPPI BOARD OF WATER COMMISSIONERS

CLARKE

H 10

3-17-65

WATER WELL DRILLERS LOG

Date: 3-17, 1965, Driller: McDonald & Hill County Greene  
(Name)

(1) Owner of Land: Myrtle Simpson  
(Name)  
Rt #1 Quitman, Miss.  
(Address)

(2) Location:  $\frac{1}{4}$ ,  $\frac{1}{4}$ , Sec. 7  $\frac{3}{4}$  N  $\frac{1}{2}$  E  
5 miles N of Quitman  
(distance) (direction) (Nearest Town)

(3) Topography: \_\_\_\_\_  
(Hilly) (Flat) (Level)

(4) Purpose of Well: Domestic  
(Domestic Irrigation  
Municipal, Industrial, Other)

Description & Color of Materials Sand, Clay, Red Clay, Shell, etc.	Thick- ness Feet	Depth Feet
CLAY	0	20
Shale	20	110
Sand	110	220
Sandy lime	220	235
Shale	235	260
Sand #12	260	272
lime sand, sandy shell	272	300

Information upon completion of well:

(1) Diameter 4 inches.

(2) Total Depth 300 feet.

(3) Water Level 50 ft feet below top of ground.

(4) Cased to 240 ft, Size 4"


(5) Screen: Size \_\_\_\_\_, Length \_\_\_\_\_.

(6) Were any formations sealed against pollution?  
\_\_\_\_\_ yes,  no.

If YES depth of formation \_\_\_\_\_

Why \_\_\_\_\_

Drillers Remarks: \_\_\_\_\_

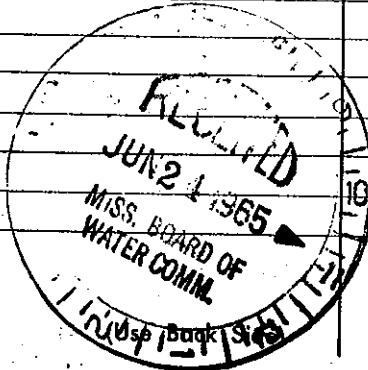

Well No. \_\_\_\_\_

Return this copy for your office files.