

CLARKE MISSISSIPPI BOARD OF WATER COMMISSIONERS

6 H17  
4-26-63

WATER WELL DRILLERS LOG

Date: 4-26, 1963, Driller: Leop. Chattam County Clarke  
(Name)

(1) Owner of Land: C. H. Culpepper  
(Name)  
  
(Address)  
  
(2) Location: 1/4, 1/4, Sec 23 3N 16E T. R.  
6 miles NE, of Princeton  
(distance) (direction) (Nearest Town)  
  
(3) Topography: Kelly  
(Hilly) (Flat) (Level)  
  
(4) Purpose of Well: Domestic  
(Domestic Irrigation, Municipal, Industrial, Other)

Description & Color of Materials Sand, Clay, Red Clay, Shell, etc.	Thick- ness Feet	Depth Feet
Clay	0	10
Clay - sdy. clay	10	23
Shale	23	40
Sand & Chalk	40	50
Sand	50	123
Shale	123	140
Thinly & finely shale	140	148
Sand	148	157
Thinly shale	157	286
Sand	286	290
Shale	290	302
Sand	302	312
clayey shale	312	330


Information upon completion of well:

(1) Diameter 3 1/4 inches.  
(2) Total Depth 330 feet.  
(3) Water Level 46 feet below top of ground.  
(4) Cased to 167, Size 4  
(5) Screen: Size \_\_\_\_\_, Length \_\_\_\_\_  
(6) Were any formations sealed against pollution?  
\_\_\_\_\_ yes, \_\_\_\_\_ no.

If YES depth of formation \_\_\_\_\_

Why \_\_\_\_\_

Drillers Remarks: Can be  
screened from  
302-309-12 slot

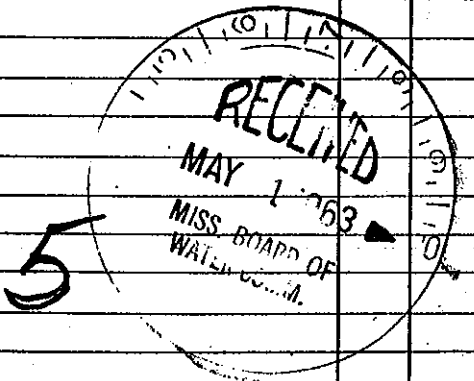

Well No.

(Use Back Side)

Mail this copy to Board of Water Commissioners 429 Miss. St. Jackson, Miss