

MISSISSIPPI BOARD OF WATER COMMISSIONERS

CLARK

H 18

4-10-63

WATER WELL DRILLERS LOG

*W. Donald Hill Inc.*

Date: 4-10, 1963, Driller: J. B. Chatham County Clarke

(Name)

(1) Owner of Land: W. H. Heathcote  
 (Name)  
Quitman, Miss  
 (Address) 3N 16E

(2) Location: 1/4, 1/4, Sec. 34 T. R  
1 miles N.E., of \_\_\_\_\_  
 (distance) (direction) (Nearest Town)

(3) Topography: Flat  
 (Hilly) (Flat) (Level)

(4) Purpose of Well: Domestic  
 (Domestic Irrigation  
 Municipal, Industrial, Other)

Description & Color of Materials Sand, Clay, Red Clay, Shell, etc.	Thick- ness Feet	Depth Feet
<u>Sandy clay</u>	<u>0</u>	<u>8</u>
<u>shale</u>	<u>8</u>	<u>22</u>
<u>sand w/shale breaks</u>	<u>22</u>	<u>28</u>
<u>limey shale + limst</u>	<u>28</u>	<u>60</u>
<u>of shale</u>	<u>60</u>	<u>69</u>
<u>shale w/ lime streaks</u>	<u>69</u>	<u>80</u>
<u>shale</u>	<u>80</u>	<u>92</u>
<u>limey sand &amp; shale</u>	<u>92</u>	<u>99</u>
<u>shale</u>	<u>99</u>	<u>105</u>
<u>sandy shale</u>	<u>105</u>	<u>108</u>
<u>sandy shale &amp; sand</u>	<u>108</u>	<u>115</u>
<u>sand w/shale streaks</u>	<u>115</u>	<u>140</u>
<u>sand</u>	<u>140</u>	<u>150</u>

Information upon completion of well:

(1) Diameter 3 1/4 inches.

(2) Total Depth 150 feet.

(3) Water Level 45 feet below top of ground.

(4) Cased to 93, Size 4


(5) Screen: Size \_\_\_\_\_, Length \_\_\_\_\_

(6) Were any formations sealed against pollution?  
 \_\_\_\_\_ yes,  no.

If YES depth of formation \_\_\_\_\_

Why \_\_\_\_\_

Drillers Remarks: \_\_\_\_\_

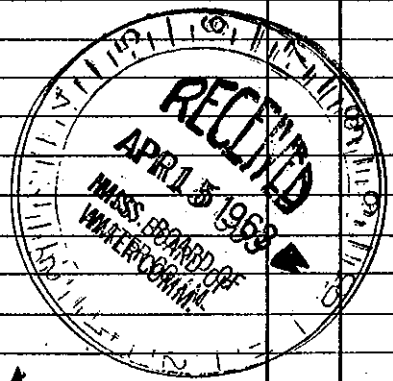

4

Well No.

(Use Back Side)

Mail this copy to Board of Water Commissioners 429 Miss. St. Jackson, Miss