

CLARKE MISSISSIPPI BOARD OF WATER COMMISSIONERS


6 H 19  
7-5-63

WATER WELL DRILLERS LOG

Date: 7-5-1963, Driller: Mc Donald & Will county Clarke

(Name)

(1) Owner of Land: <u>W L James Jr</u> (Name)	Description & Color of Materials Sand, Clay, Red Clay, Shell, etc.	Thick- ness Feet	Depth Feet
(Address) <u>3N 16E</u>	<u>Clay</u>	<u>0</u>	<u>0</u>
(2) Location: <u>1/4</u> , <u>1/4</u> , Sec. <u>1</u> T. <u>R.</u>	<u>Sdy. Clay &amp; sd</u>	<u>0</u>	<u>5</u>
<u>10</u> miles <u>Ne East</u> , of <u>Quitman</u> (distance) (direction) (Nearest Town)	<u>Sh. w/pt. clay &amp; Chalk</u>	<u>20</u>	<u>120</u>
(3) Topography: <u>Hilly</u> (Hilly) (Flat) (Level)	<u>limy shale</u>	<u>120</u>	<u>141</u>
(4) Purpose of Well: <u>Domestic</u> (Domestic Irrigation Municipal, Industrial, Other)	<u>sand</u>	<u>141</u>	<u>146</u>
	<u>limy shale</u>	<u>146</u>	<u>180</u>
	<u>shale</u>	<u>180</u>	<u>190</u>
	<u>limy shale</u>	<u>190</u>	<u>260</u>
	<u>sdy shale &amp; sd</u>	<u>260</u>	<u>265</u>
	<u>sdy shale</u>	<u>265</u>	<u>273</u>
	<u>sand</u>	<u>273</u>	<u>281</u>
	<u>shale</u>	<u>281</u>	<u>285</u>
	<u>sd. w/shale breaks</u>	<u>285</u>	<u>293</u>
	<u>sand</u>	<u>293</u>	<u>310</u>
Information upon completion of well: (1) Diameter <u>3 1/4</u> inches. (2) Total Depth <u>310</u> feet. (3) Water Level <u>96</u> feet below top of ground. (4) Cased to <u>15'</u> , Size <u>4</u> (5) Screen: Size _____, Length _____ (6) Were any formations sealed against pollution? _____ yes, _____ no. If YES depth of formation _____ Why _____			
Drillers Remarks: <u>Con screen</u> <u>293-310</u>			

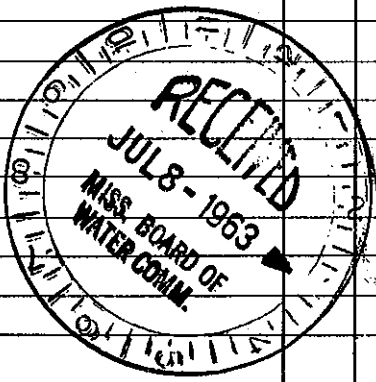

Well No.

(Use Back Side)

Mail this copy to Board of Water Commissioners 429 Miss. St. Jackson, Miss.