

CLARK MISSISSIPPI BOARD OF WATER COMMISSIONERS

~~H 20~~
34-62

WATER WELL DRILLERS LOG 21 ✓ P

Date: April, 1962, Driller: Peoples & Rutledge County Clarke
(Name)

(1) Owner of Land: Chester Johnston
(Name)
Quitman, Miss
(Address)

(2) Location: NE 1/4, SE 1/4, Sec. 33 T.3 R.45
6 miles East of Quitman
(distance) (direction) (Nearest Town)

(3) Topography: Hilly
(Hilly) (Flat) (Level)

(4) Purpose of Well: Domestic
(Domestic Irrigation
Municipal, Industrial, Other)

Description & Color of Materials Sand, Clay, Red Clay, Shell, etc.	Thick- ness Feet	Depth Feet
Top to Red Sandy clay	31	31
blue sandy shale	32	63
salt & pepper sand + small shale streak	42	105
lime & limestone	84	189
gray sandy shale	26	215
White coarse sand	16	231


Information upon completion of well:

- (1) Diameter 2'' inches.
- (2) Total Depth 231 feet.
- (3) Water Level 122 feet below top of ground.
- (4) Cased to 225, Size 2''
- (5) Screen: Size 2'', Length 6'
- (6) Were any formations sealed against pollution?
_____ yes, no.

If YES depth of formation _____

Why _____

Drillers Remarks: _____

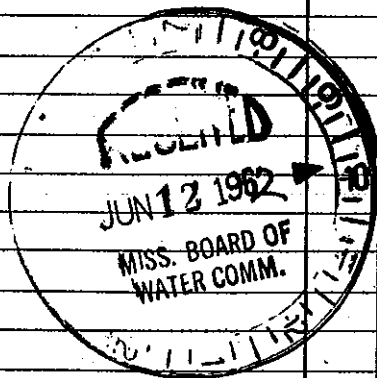

(Use Back Side)

Well No.

Mail this copy to Board of Water Commissioners 429 Miss. St. Jackson, Miss.