

MISSISSIPPI BOARD OF WATER COMMISSIONERS

Clarke
H24

WATER WELL DRILLERS LOG

12-6-60

Date: 12.6.60, 19___, Driller: McDonald, Hill, Clarke
(Name) Lauderdale Co

CODED 7

(1) Owner of Land: P. H. Gabel
(Name)
Quitman
(Address)
(2) Location: 30 3^N 16^E
3 miles North East of Quitman
(distance) (direction) (Nearest Town)
(3) Topography: X
(Hilly) (Flat) (Level)
(4) Purpose of Well: Domestic
(Domestic Irrigation, Municipal, Industrial, Other)

Description & Color of Materials Sand, Clay, Red Clay, Shell, etc.	Thick- ness Feet	Depth Feet
<u>Top Soil Clay</u>	<u>0</u>	<u>10</u>
<u>Sandy Clay</u>	<u>10</u>	<u>28</u>
<u>Sandy Loam</u>	<u>28</u>	<u>60</u>
<u>Soft Limestone Rock</u>	<u>60</u>	<u>62</u>
<u>med gravel</u>	<u>62</u>	<u>75</u>
<u>Sand</u>	<u>75</u>	<u>152</u>

Information upon completion of well:

(1) Diameter 2 inches.

(2) Total Depth 132 feet.

(3) Water Level 40 feet below top of ground.

(4) Cased to 132, Size 2

(5) Screen: Size 2, Length 5


(6) Were any formations sealed against pollution?
_____ yes, _____ no.

If YES depth of formation _____

Why _____

Drillers Remarks: _____

CODED

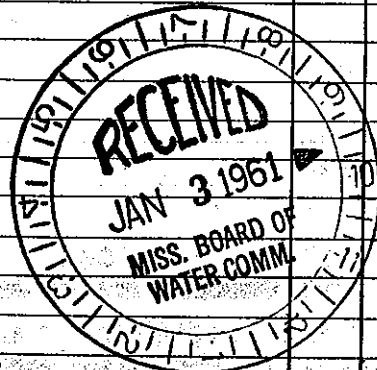

(Use Back Side)

Mail this copy to Board of Water Commissioners 429 Miss. St. Jackson,