

Clarke
H 25
8-69

MISSISSIPPI
BOARD OF WATER COMMISSIONERS
416 North State Street
Jackson, Mississippi 39201

CODED

WATER WELL DRILLERS LOG

8.29.67 date well completed
McDONALD HILL firm name
CLARK county well located

LANDOWNER: CHARLES TVEY

QUITMAN

(mailing address)

WELL LOCATION:

sec. 24 T 3 N R 16 E
mi/NEAST of QUITMAN
(distance) (direction) (nearest town)

WELL PURPOSE: HOME
(home, irrigation, municipal, industrial)

WELL COMPLETION DATA:


- (1) diameter (inches) 4" WELL
- (2) total depth (feet) 360
- (3) static water level (feet) 125' below top of ground.
- (4) casing BLACK 170 (material) (depth)
4" (size) if telescope see back.
- (5) screen NO (length) NO (depth to top)
NO (size) NO (material)
- (6) pump 1/2 sub 6 (HP) (yield gpm)
320 (type power)
- (7) electric log NO (yes or no)
NO (organization running log)
- (8) how well bottom plugged OPEN

description of formations encountered

from to

CLAY	0	12
SAND CLAY	12	30
SHALE	30	55
SAND	55	75
SHALE	75	92
SANDY SHALE	92	160
SHALE	160	180
ROCK	180	186
SANDY	186	197
SHALE ST. ROCK	197	330
FINE SAND		
SAND	240	350
SANDY	350	360

CODED

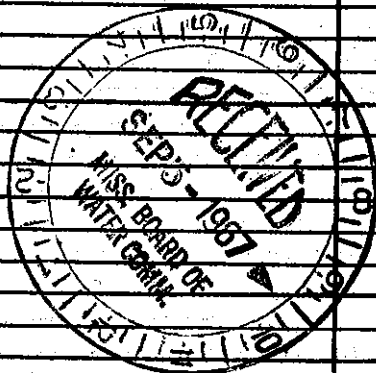

DRILLERS REMARKS: