

3 13T.

320640N 0884830

CLARKE

H27

10-68

MISSISSIPPI
BOARD OF WATER COMMISSIONERS
416 North State Street
Jackson, Mississippi 39201

CODED ^{WN?}

WATER WELL DRILLERS LOG

Oct 19 68 Peoples Drilling Co Clarke
date well completed firm name county well located


| LANDOWNER: <u>Randall Daggitt</u> | description of formations encountered | from | to |
|---|---------------------------------------|------------|------------|
| | | | |
| | <u>Yellow Sand</u> | <u>0</u> | <u>81</u> |
| <u>Quitman, Miss</u> (mailing address) | <u>Blue Wailt Rock</u> | <u>81</u> | <u>231</u> |
| WELL LOCATION: sec <u>7</u> T <u>30</u> N R <u>16</u> E <u>5</u> miles <u>N</u> of <u>Quitman</u> (distance) (direction) (nearest town) | <u>Blue sandy shale</u> | <u>231</u> | <u>252</u> |
| | <u>White sand & clay streaks</u> | <u>252</u> | <u>273</u> |

WELL PURPOSE: Home
(home, irrigation, municipal, industrial)

WELL COMPLETION DATA:

- (1) diameter (inches) H
- (2) total depth (feet) 273
- (3) static water level (feet) 92 ^{below} _{above} top of ground.
- (4) casing Iron 147
(material) (depth)
4"
(size) if telescope see back.
- (5) screen None
(length) (depth to top)
(size) (material)
- (6) pump 1/2 15
(HP) (yield gpm)
elect
(type power)
- (7) electric log No
(yes or no)
(organization running log)
- (8) how well bottom plugged open

CODED

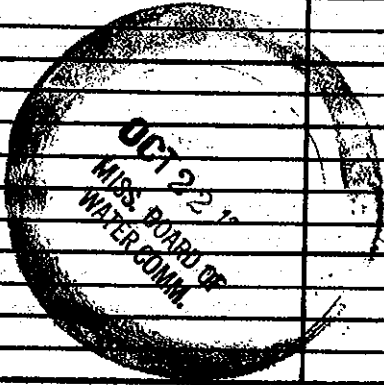

DRILLERS REMARKS: