

CLARKE

H 33

4-16-74

MISSISSIPPI BOARD OF WATER COMMISSIONERS
416 North State Street
Jackson, Mississippi 39201

CODED

WATER WELL DRILLERS LOG

4-16-74
date well completed

Mc DONALD + HILL
firm name

CLARKE
county well located

LANDOWNER:
ANNIE RUTH MCCARRA
QUITMAN MISS
(mailing address)


description of formations encountered	from	to
CLAY	0	16
SAND	16	50
SHALE	50	75
ROCK	75	85
GREEN SAND STRIKE	85	120
ROCK ST SHALE	120	200
SAND	200	240

WELL LOCATION:
sec. 18 T. 30 N. R. 10 E
1 miles EAST CLARK PARK
(distance) (direction) (nearest town)

WELL PURPOSE: HOME
(home, irrigation, municipal, industrial)

- WELL COMPLETION DATA:
- (1) diameter (inches) 4"
 - (2) total depth (feet) 240'
 - (3) static water level (feet) 36' below top of ground.
 - (4) casing PVC 70' (material) (depth)
4" (size) if telescope see back.
 - (5) screen (length) (depth to top)
(size) (material)
 - (6) pump 1/2 Jet 10 (HP) (yield gpm)
ELECTRIC (type power)
 - (7) electric log (yes or no)
(organization running log)
 - (8) how well bottom plugged OPEN

CODED

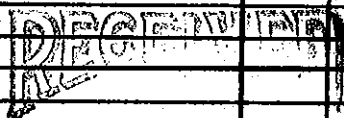

APR 19 1974

DRILLERS REMARKS: