

MISSISSIPPI DEPARTMENT OF NATURAL RESOURCES

Bureau of Land and Water Resources

Southport Mall

P.O. Box 10631

Jackson, Mississippi 39209


WATER WELL DRILLERS LOG

CODED

CLARKE
H-40
4/7/81

4-7-81 19 McDonald & Hill Clarke
date well completed firm name county well located

LANDOWNER:	description of formations encountered	from	to
Rev. R. A. Givens	clay & sand	0	30
Rt # 1 Box 37 - B Quitman (mailing address)	sand	30	130
WELL LOCATION: sec. 17 T 3 N R 16 E 5 miles NE of Quitman (distance) (direction) (nearest town)	sandy shale	130	135
	shale	135	150
WELL PURPOSE: home (home, irrigation, municipal, industrial)	Rock & shells	150	175
WELL COMPLETION DATA:	green sand & sandy shale	175	185
(1) diameter (inches) 4"	Rock & shale	185	290
(2) total depth (feet) 330'	sand & shale	290	320
(3) static water level (feet) 75 below top of ground.	course sand	320	330
(4) casing PVC 147' (material) (depth) 4" if telescope see back. (size)			
(5) screen (length) (depth to top) (size) (material)			
(6) pump 1/2 8000 (HP) (yield gpm) F (type power)			
(7) electric log (yes or no)			
(organization running log)			
(8) how well bottom plugged Open			
DRILLERS REMARKS:			

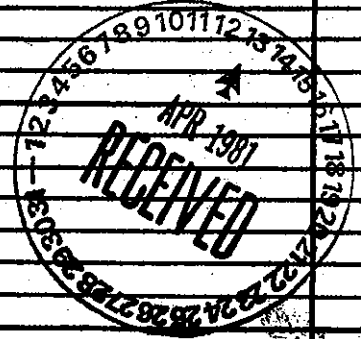

DEPT. OF NATURAL RESOURCES
BUREAU OF LAND & WATER RESOURCES

APR 13 1981
RECEIVED