

Clarke
3 J 2
1-67

MISSISSIPPI
BOARD OF WATER COMMISSIONERS
416 North State Street
Jackson, Mississippi 39201

WATER WELL DRILLERS LOG

1-16-67 19 *Donald V. Hill* CLARK
date well completed firm name county well located

LANDOWNER: MELTON CASEY
R# 2 QUITMAN
(mailing address)


description of formations encountered	from	to
CLAY ST SAND	0	36
SHALE	36	90
SHALE ST ROCK	90	205
SAND	205	215
SANDY SHALE	215	230

WELL LOCATION:
sec 26 T 2 N R 17 E
S W
9 miles NORTH of CRANDALL
(distance) (direction) (nearest town)

WELL PURPOSE: HOME
(home, irrigation, municipal, industrial)

- WELL COMPLETION DATA:
- diameter (inches) 4" WELL
 - total depth (feet) 230'
 - static water level (feet) 70 below above top of ground.
 - casing BLACK, 175'
(material) (depth)
4"
(size) if telescope see back.
 - screen OPEN, BOTTOM
(length) (depth to top)
(size) (material)
 - pump 1/2, 10
(HP) (yield gpm)
330
(type power)
 - electric log NO
(yes or no)
(organization running log)
 - how well bottom plugged OPEN

Handwritten mark resembling a stylized 'S' or '2'.

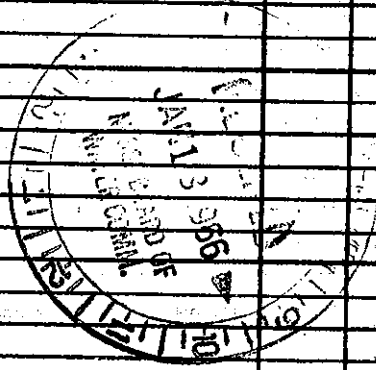

DRILLERS REMARKS: