

6 CLARKE

J B

2-28-62

MISSISSIPPI BOARD OF WATER COMMISSIONERS

CODED P

WATER WELL DRILLERS LOG

Date: 2, 28, 1962, Driller: McDONALD HILL County CLARK
(Name)

(1) Owner of Land:	Description & Color of Materials Sand, Clay, Red Clay, Shell, etc.	Thick- ness Feet	Depth Feet
SIDNEY HAROLD (Name)	CLAY	0	10
R#4 QUITMAN (Address)	SAND	10	101
(2) Location: 1/4, 1/4, Sec. 24 31N 17E	SHALE	101	130
14 miles N EAST, of QUITMAN (distance) (direction) (Nearest Town)	SHALE ST ROCK	130	215
(3) Topography: X (Hilly) (Flat) (Level)	SAND	215	280
(4) Purpose of Well: DOMESTIC (Domestic Irrigation Municipal, Industrial, Other)	SAND SHALE	240	260

Information upon completion of well:

- (1) Diameter 4" inches.
- (2) Total Depth 260' feet.
- (3) Water Level 195 feet below top of ground.
- (4) Cased to 126', Size 4"
- (5) Screen: Size _____, Length _____
- (6) Were any formations sealed against pollution?
_____ yes; _____ no.


CODED

3

If YES depth of formation _____

Why _____

Drillers Remarks: _____

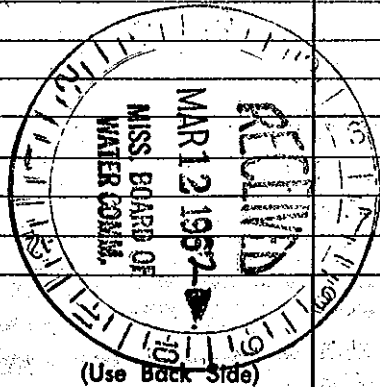

(Use Back Side)

Well No. _____

Retain this copy for your office files.