

Clarke  
3 J4  
5-67

MISSISSIPPI  
BOARD OF WATER COMMISSIONERS  
416 North State Street  
Jackson, Mississippi 39201

WATER WELL DRILLERS LOG

MAY 1967 PEOPLES DRILLING CO. CLARKE  
date well completed: firm name county well located

LANDOWNER: IRA FULLER

QUITMAN, Miss.

(mailing address)

WELL LOCATION:


sec. 35 T. 3 (N) R. 17 (E)  
11 miles E of QUITMAN  
(distance) (direction) (nearest town)

WELL PURPOSE: HOME  
(home, irrigation, municipal, industrial)

WELL COMPLETION DATA:

- (1) diameter (inches) 4"
- (2) total depth (feet) 462'
- (3) static water level (feet) 87' <sup>below</sup> / <sub>above</sub> top of ground.
- (4) casing IRON 336'  
(material) (depth)  
4" (size) If telescope see back.
- (5) screen NONE  
(length) (depth to top)
- (6) pump 1/2 12  
(HP) (yield gpm)  
ELEC  
(type power)
- (7) electric log NO  
(yes or no)
- (organization running log)
- (8) how well bottom plugged OPEN

| description of formations encountered | from to |     |
|---------------------------------------|---------|-----|
|                                       |         |     |
| YELLOW SAND                           | 0       | 12  |
| YELLOW CLAY                           | 12      | 22  |
| YELLOW SAND                           | 22      | 61  |
| BLUE CLAY                             | 61      | 84  |
| BLUE MARL + ROCK                      | 84      | 205 |
| SANDY SHALE + FINE GRAY SAND          |         |     |
| STREMS                                | 205     | 399 |
| HARD ROCK                             | 399     | 404 |
| GRAY SANDY SHALE                      | 404     | 462 |

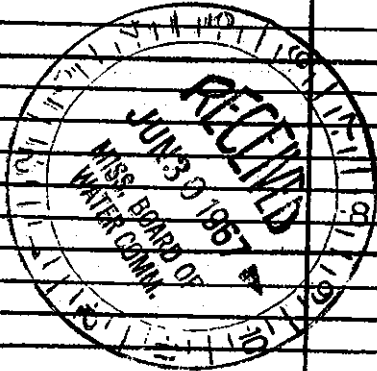

DRILLERS REMARKS: