

Clarke

3-15
11-66

MISSISSIPPI BOARD OF WATER COMMISSIONERS

WATER WELL DRILLERS LOG

2


Date: 11-26, 1966, Driller: M^c Donald Hill County Clarke
(When well drilled) (Name) (Where well is located)

(1) Owner of Land	Description & Color of Materials Sand, Clay, Red Clay, Shell, etc.	Thick- ness Feet	Depth Feet
WASHINGTON MCKENZIE (Name)	Sand & Clay	22	22
Rt #2, Quitman, Miss. (Address)	Shale & Rock	88	110
(2) Location: SW 1/4, NW 1/4, Sec. 36 N E T3 R17	Rock & Shell	85	195
8 miles NORTH of SPANGLALL (distance) (direction) (Nearest Town)	Sand & Shale	30	225
(3) Topography: X (Hilly) (Flat) (Level)	Shale	25	250
(4) Purpose of Well: DOMESTIC (Domestic Irrigation Municipal, Industrial, Other)	Sand	10	260
	Shale	75	335
	Sand	15	350
	Sandy & Shale	30	380

Information upon completion of well:

- (1) Diameter 4" WELL inches.
- (2) Total Depth 380' feet.
- (3) Water Level 90' feet below top of ground.
- (4) Cased to 277', Size 4" BLACK
- (5) Screen: Size 2", Length 10'
- (6) Were any formations sealed against pollution?
yes, X no.

277
84
361

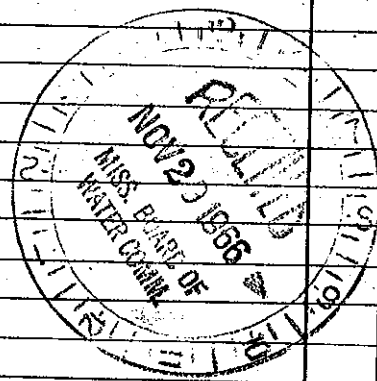

If YES depth of formation _____
Why _____
Drillers Remarks: _____
Yield in gpm: 50
Size pump: 1/2 HP SUB
Type power: 230 V.

Mail this copy to Board of Water Commissioners 429 Miss. St. Jackson, Miss.