

WATER WELL DRILLERS LOG

Date: 7, 5, 1963, Driller: JAMES MATLOCK County Lauderdale


(1) Owner of Land: WESLEY SLAY (Name)
R#4 QUITMAN (Address)
(2) Location: 1/4, 1/4, Sec. 20 3N 17E T R
10 miles EAST of QUITMAN (distance) (direction) (Nearest Town)
(3) Topography: X (Hilly) (Flat) (Level)
(4) Purpose of Well: DOMESTIC (Domestic Irrigation Municipal, Industrial, Other)

Table with 4 columns: Description & Color of Materials, Thickness Feet, Depth Feet. Rows include CLAY, SANDY CLAY, SHALE, SHELLS ST SAND, RED SANDY SHALE, FINE SAND, SAND NO 12.

Information upon completion of well:

(1) Diameter 3/4 inches.
(2) Total Depth 235' feet.
(3) Water Level 112' feet below top of ground.
(4) Cased to 228', Size 2"
(5) Screen: Size 2", Length 4'
(6) Were any formations sealed against pollution?
yes, no.
If YES depth of formation
Why
Drillers Remarks:

4

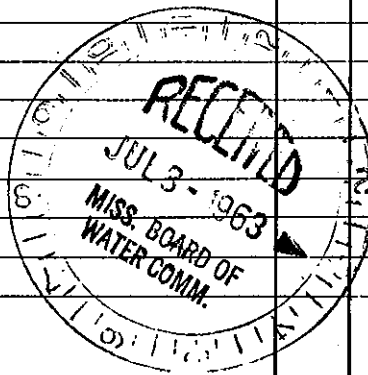

Well No.

(Use Back Side)

Mail this copy to Board of Water Commissioners 429 Miss. St. Jackson, Miss.