

CLARKE MISSISSIPPI BOARD OF WATER COMMISSIONERS

6J8
4-24-64

WATER WELL DRILLERS LOG

Date: 4-24, 1964, Driller: McDonald + Hill County Lauderdale

(Name)

(1) Owner of Land: <u>ROBERT HARRIS</u> (Name)	Description & Color of Materials Sand, Clay, Red Clay, Shell, etc.	Thick- ness Feet	Depth Feet
<u>Rt. #4, Quitman, Miss</u> (Address)	15-66 Clay + sand	0	15
(2) Location: <u>3/4</u> , <u>3/4</u> , Sec <u>19</u> <u>3N</u> <u>17E</u> T R	15-66 Shale	15	66
<u>10</u> miles <u>EAST</u> , of <u>Quitman</u> (distance) (direction) (Nearest Town)	15-66 Shale	6	120
(3) Topography: <u>HILLY</u> (Hilly) (Flat) (Level)	Shale	120	176
(4) Purpose of Well: <u>DOMESTIC</u> (Domestic Irrigation Municipal, Industrial, Other)	Sandy str	176	180
	Sand	180	192
	Sand + shale str	192	215
	Sand	215	223
	Shale + sand str	223	230


Information upon completion of well:

- (1) Diameter 4 inches.
- (2) Total Depth 230 feet.
- (3) Water Level 75 feet below top of ground.
- (4) Cased to 222, Size 4x2
- (5) Screen: Size 2, Length 6 ft
- (6) Were any formations sealed against pollution?
_____ yes, no.

If YES depth of formation _____

Why _____

Drillers Remarks: _____

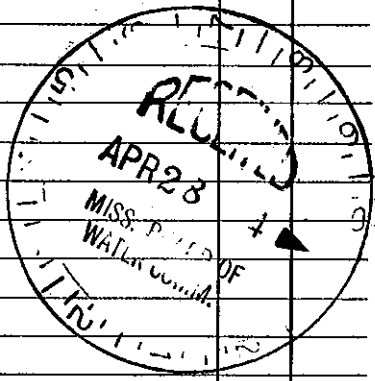

Well No.

(Use Back Side)

Mail this copy to Board of Water Commissioners 429 Miss. St. Jackson, Miss