

Clarke

MISSISSIPPI BOARD OF WATER COMMISSIONERS

J12
6-5-64

WATER WELL DRILLERS LOG

Date: 6.5, 1964, Driller: M^r Donald & Hill Clarke
(Name)

COVERED

(1) Owner of Land: J.R. Robinson
(Name)
R#1 OBITMAN
(Address)

(2) Location: 9 3N 17E
_____ miles _____ of _____
(distance) (direction) (Nearest Town)

(3) Topography: X
(Hilly) (Flat) (Level)

(4) Purpose of Well: DOMESTIC
(Domestic Irrigation
Municipal, Industrial, Other)

Description & Color of Materials Sand, Clay, Red Clay, Shell, etc.	Thick- ness Feet	Depth Feet
CLAY	0	10
SAND	10	50
SHALE ST ROCK	50	180
SAND	180	220
SHALE	220	280
SOFT SHALE	280	325
SAND NO 10	325	340
FINE SAND	340	380
SANDY SHALE	380	450
SOFT SHALE	450	500
SHALE ST FINE SAND	500	550

Information upon completion of well:

(1) Diameter 4" inches.

(2) Total Depth 550' feet.

(3) Water Level 170' feet below top of ground.

(4) Cased to 270, Size 4"

(5) Screen: Size _____, Length _____


(6) Were any formations sealed against pollution?
_____ yes, _____ no.

If YES depth of formation _____

Why _____

Drillers Remarks: _____

COVERED

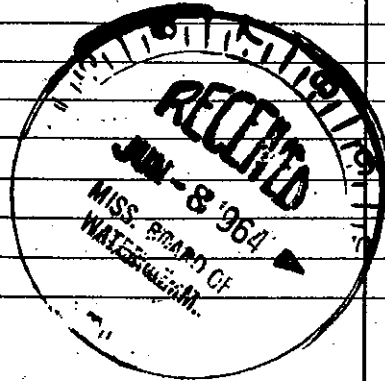

Well No.

(Use Back Side)

Mail this copy to Board of Water Commissioners 429 Miss. St. Jackson, Miss.