


COMMISSIONERS

WATER WELL DRILLERS LOG

3 L3  
12-61

Date: 12, 19 61, Driller: Peoples & Rutledge County Clarke  
(Name)

(1) Owner of Land: <u>William Eddins</u> <u>Matt Eddins</u> (Name)	Description & Color of Materials Sand, Clay, Red Clay, Shell, etc.	Thick- ness Feet	Depth Feet
(Address)	<u>Sandy Clay</u>	<u>18</u>	<u>18</u>
(2) Location: <u>SW 1/4, SE 1/4, Sec. 30 T.2 R.14</u>	<u>Yellow Sand</u>	<u>13</u>	<u>31</u>
<u>app. 1</u> miles <u>South</u> , of <u>Barnett</u> (distance) (direction) (Nearest Town)	<u>Blue shale</u>	<u>74</u>	<u>105</u>
(3) Topography: <u>flat</u> (Hill) (Flat) (Level)	<u>Lime and Chert</u>	<u>26</u>	<u>131</u>
(4) Purpose of Well: <u>Domestic</u> (Domestic Irrigation Municipal, Industrial, Other)	<u>Fine Gray Sand</u>	<u>64</u>	<u>195</u>
Information upon completion of well:			
(1) Diameter <u>2</u> / <u>195</u> inches.			
(2) Total Depth <u>195</u> feet.			
(3) Water Level <u>63</u> feet below top of ground.			
(4) Cased to <u>189'</u> , Size <u>2"</u>			
(5) Screen: Size <u>2"</u> , Length <u>6'</u>			
(6) Were any formations sealed against pollution? <u>no</u>			
If YES depth of formation _____			
Why _____			
Drillers Remarks: _____			
_____			
_____			
_____			
_____			

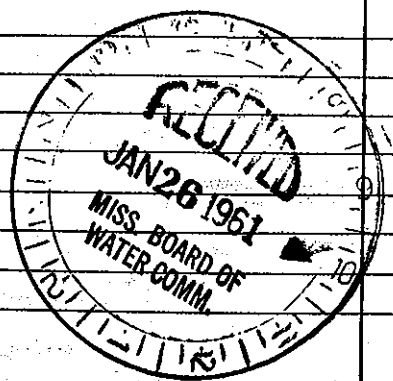

(Use Back Side)

Well No.

Mail this copy to Board of Water Commissioners 429 Miss. St. Jackson, Miss.