

CLARKE MISSISSIPPI BOARD OF WATER COMMISSIONERS

3 L 6

9-23-64

WATER WELL DRILLERS LOG

Date: 9. 23, 1964, Driller: M^c Donald d Hill Inc
County Jasper

MERRIAL

(Name)

(1) Owner of Land: <u>C. T. MERRIAL</u>	Description & Color of Materials Sand, Clay, Red Clay, Shell, etc.	Thick- ness Feet	Depth Feet
(Name)			
<u>PACHUTA MISS</u>			
(Address)			
(2) Location: <u>SW 1/4, NE 1/4, Sec. 30 T. 24 N. R. 14 E</u>			
<u>5</u> miles <u>South</u> , of <u>Pachuta</u>			
(distance) (direction) (Nearest Town)			
(3) Topography: <u>X</u>			
(Hilly) (Flat) (Level)			
(4) Purpose of Well: <u>DOMESTIC</u>			
(Domestic Irrigation Municipal, Industrial, Other)			


Information upon completion of well:

- (1) Diameter 3 1/4 inches. TEST HOLE
- (2) Total Depth 217 feet.
- (3) Water Level 80 feet below top of ground.
- (4) Cased to 210, Size 2"
- (5) Screen: Size 2", Length 8' DRASS
- (6) Were any formations sealed against pollution?
 yes, no.

If YES depth of formation _____

Why _____

Drillers Remarks: _____

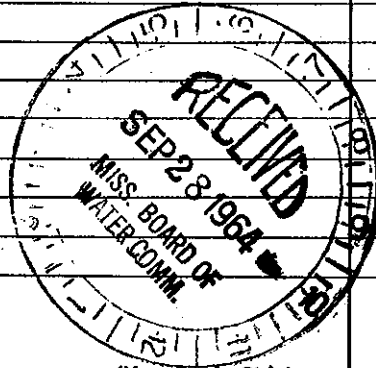

(Use Back Side)

Well No. _____

Mail this copy to Board of Water Commissioners 429 Miss. St. Jackson, Mis: