

Clark  
 L9  
 1-68  
 Elec Log

MISSISSIPPI  
 BOARD OF WATER COMMISSIONERS  
 416 North State Street  
 Jackson, Mississippi 39201

WATER WELL DRILLERS LOG

19 McDonald + Hill CLARK  
 date well completed firm name county well located

LANDOWNER: BARNETT ASSOCIATES

description of formations encountered	from	to
Clay	0	12
Blue Clay	12	72
Sandy	72	124
Prismatic Shale	124	142
fine sand	142	157
Soft shale fine sand	157	168
fine sand & shale	168	194
Shale	194	228
Rock & Shale	228	260
Rock & Shale	260	295
Shale	295	310
Sand	310	330
fine sand	330	340
Sand	340	419

BARNETT MISC

(mailing address)

WELL LOCATION:

sec. 33 T 2 N R 14 E  
 S W  
2 miles EAST of BARNETT  
 (distance) (direction) (nearest town)


WELL PURPOSE:

(home, irrigation, municipal, industrial)

WELL COMPLETION DATA:

- (1) diameter (inches) 4"
- (2) total depth (feet) 410'
- (3) static water level (feet) 80' below top of ground.
- (4) casing BLACK, 210',  
 (material) (depth)  
4" If telescope see back.  
 (size)
- (5) screen 20', 310'  
 (length) (depth to top)  
2", BRASS  
 (size) (material)
- (6) pump 3HP, 40  
 (HP) (yield gpm)  
230  
 (type power)
- (7) electric log YES  
 (yes or no)  
V S GEOLOGICAL  
 (organization running log)
- (8) how well bottom plugged VALUE

CODED

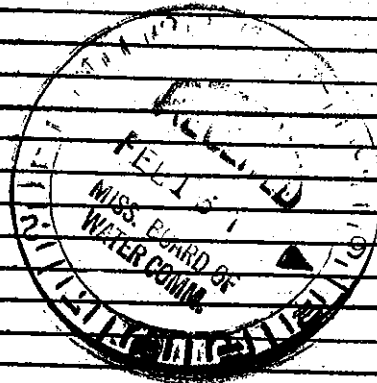

DRILLERS REMARKS: