


CLARKE
L 10
3-68

MISSISSIPPI
BOARD OF WATER COMMISSIONERS
416 North State Street
Jackson, Mississippi 39201

WATER WELL DRILLERS LOG

March 19 68 Reeper Drilling Co Clarke
date well completed firm name county well located

LANDOWNER:	description of formations encountered	from	to
Richard J. Plummer PLUMMER	yellow sandy clay	0	15
Pachuta, Miss. (mailing address)	yellow sand	15	23
WELL LOCATION: sec. 9 T. 20 N. R. 8 E 1 miles SE of Pachuta (distance) (direction) (nearest town)	brown staly sand	23	126
WELL PURPOSE: Home (home, irrigation, municipal, industrial)	green limy staly	126	168
WELL COMPLETION DATA: (1) diameter (inches) 2 (2) total depth (feet) 336 (3) static water level (feet) 70 (below above top of ground) (4) casing Galv 330 (material) (depth) 2" (size) If telescope see back. (5) screen 6' 330' (length) (depth to top) 2" (size) Brass (material) (6) pump 1/2 6 (HP) (yield gpm) elect (type power) (7) electric log NO (yes or no) (organization running log) (8) how well bottom plugged back with water	lime + limestone	168	252
	brown staly & sand staly	252	273
	white sand	273	336

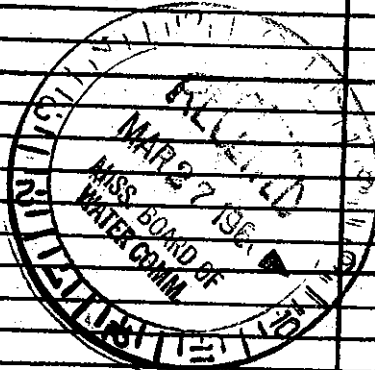

DRILLERS REMARKS: