

LEB
7-65

WATER WELL DRILLERS LOG

Date: July, 1965, Driller: Reeple Drilling Co County Clacke
(Name)

(1) Owner of Land: <u>Arizona Jackson</u> (Name)	Description & Color of Materials Sand, Clay, Red Clay, Shell, etc.	Thick- ness Feet	Depth Feet
<u>Pachuta, Miss</u> (Address)	<u>Yellow Sand & Sandy Clay</u>	<u>19</u>	<u>19</u>
(2) Location: <u>1/4, 1/4, Sec. 10</u> <u>2N 14E</u> T R	<u>lime</u>	<u>23</u>	<u>42</u>
<u>1 1/2</u> miles <u>E</u> of <u>Pachuta</u> (distance) (direction) (Nearest Town)	<u>Sandy strat sand (gray)</u>	<u>43</u>	<u>105</u>
(3) Topography: <u>Flat</u> (Hilly) (Flat) (Level)	<u>B. brown shale</u>	<u>80</u>	<u>185</u>
(4) Purpose of Well: <u>Home</u> (Domestic Irrigation Municipal, Industrial, Other)	<u>lime & limestone</u>	<u>67</u>	<u>252</u>
	<u>Sand & shale bits</u>	<u>21</u>	<u>273</u>
	<u>white sand</u>	<u>48</u>	<u>321</u>

Information upon completion of well:

(1) Diameter 2 inches.

(2) Total Depth 321 feet.

(3) Water Level 41 feet below top of ground.

(4) Cased to 315', Size 2"


(5) Screen: Size 2", Length 6'

(6) Were any formations sealed against pollution?
_____ yes, _____ no.

If YES depth of formation _____

Why _____

Drillers Remarks: _____

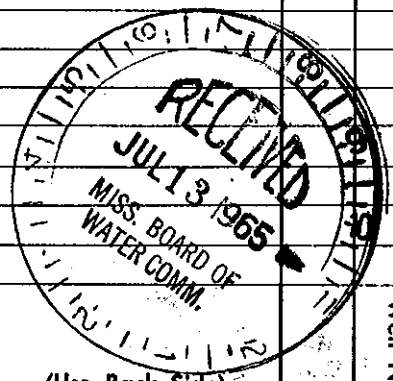

(Use Back Side)

Well No.