

CLARKE

6 L 15

5-27-63

MISSISSIPPI BOARD OF WATER COMMISSIONERS

WATER WELL DRILLERS LOG

Date: 5/27, 1963, Driller: G.P. Clark County Clarke

(Name)

(1) Owner of Land:	Description & Color of Materials Sand, Clay, Red Clay, Shell, etc	Thick- ness Feet	Depth Feet
J. H. Broadway Rt #3 Outman Miss (Name) (Address)	0-25 Yellow Clay	25	
	25-108 Sand	83	
(2) Location: 1/4, 1/4, Sec. 12 T. R. 2N 10E 6 miles East of Jackson (distance) (direction) (Nearest Town)	108-170 Clay	62	
	170-190 Clay Rocks	20	
	190-200 Clay	10	
	200-256 Sand	56	
(3) Topography: <input checked="" type="checkbox"/> (Hilly) <input type="checkbox"/> (Flat) <input type="checkbox"/> (Level)			
(4) Purpose of Well: Domestic (Domestic Irrigation, Municipal, Industrial, Other)			


Information upon completion of well:

- (1) Diameter 2 inches.
- (2) Total Depth 256 feet.
- (3) Water Level 85 feet below top of ground.
- (4) Cased to 246, Size 2 in
- (5) Screen: Size 1/4, Length 10
- (6) Were any formations sealed against pollution?  
yes,  no.

If YES depth of formation

Why

Drillers Remarks:

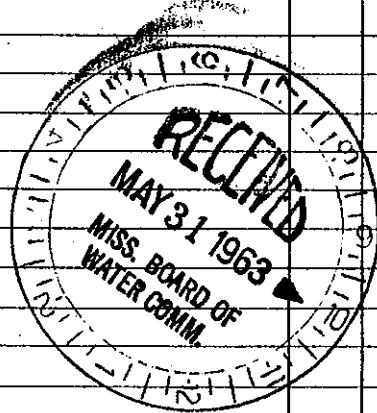

(Use Back Side)

Well No.

Mail this copy to Board of Water Commissioners 429 Miss. St. Jackson, Miss