

CLARKE

MISSISSIPPI BOARD OF WATER COMMISSIONERS

6219

5-26-62

WATER WELL DRILLERS LOG

P

Date: 5-26, 1962, Driller: M. E. Donald & Hill County: Clarke

(Name)

(1) Owner of Land: <u>James Evans -</u> (Name)	Description & Color of Materials Sand, Clay, Red Clay, Shell, etc.	Thick- ness Feet	Depth Feet
<u>Rt #3, Quitman, Miss</u> (Address)	<u>Clay</u>	<u>0</u>	<u>10</u>
(2) Location: <u>1/4, 1/4, Sec. 12 2N 14E</u> T. R.	<u>Sand</u>	<u>10</u>	<u>26</u>
<u>6</u> miles <u>West</u> , of <u>Quitman</u> (distance) (direction) (Nearest Town)	<u>Shale</u>	<u>26</u>	<u>95</u>
(3) Topography: <input checked="" type="checkbox"/> (Hilly) <input type="checkbox"/> (Flat) <input type="checkbox"/> (Level)	<u>Sand & Shale</u>	<u>95</u>	<u>110</u>
(4) Purpose of Well: <u>Domestic</u> (Domestic Irrigation Municipal, Industrial, Other)			


Information upon completion of well:

- (1) Diameter 2 inches.
- (2) Total Depth 110 feet.
- (3) Water Level 46 feet below top of ground.
- (4) Cased to 105', Size 2"
- (5) Screen: Size 2", Length 4'
- (6) Were any formations sealed against pollution?
no

If YES depth of formation _____

Why _____

Drillers Remarks: _____

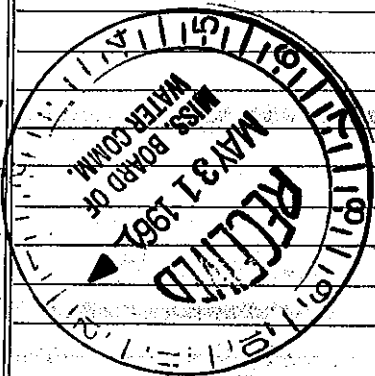

(Use Back Side)

Well No.

Mail this copy to Board of Water Commissioners 429 Miss. St. Jackson, Miss.