

CLARKE

MISSISSIPPI BOARD OF WATER COMMISSIONERS

L 20

5-27-62

WATER WELL DRILLERS LOG

Date: 5-27, 1962, Driller: McDonald & Hill County: Clarke

(Name)

(1) Owner of Land:	Description & Color of Materials Sand, Clay, Red Clay, Shell, etc.	Thick- ness Feet	Depth Feet
Banks (Name) Rt #3, Quitman, Miss (Address)	Clay Sand	0 4	4 8
(2) Location: 1/4, 1/4, Sec. 12 T. R. 6 miles West of Quitman (distance) (direction) (Nearest Town)	Shale Sandy Shale Shale & Sand	8 20 40	20 40 80
(3) Topography: (Hilly) (Flat) (Level)			
(4) Purpose of Well: Domestic (Domestic Irrigation Municipal, Industrial, Other)			


Information upon completion of well:

- (1) Diameter 2 inches.
- (2) Total Depth 81 feet.
- (3) Water Level 24 feet below top of ground.
- (4) Cased to 75, Size 2"
- (5) Screen: Size 2", Length 5'
- (6) Were any formations sealed against pollution?
yes, no.

If YES depth of formation

Why

Drillers Remarks:

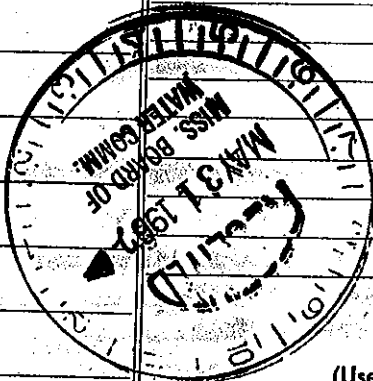

(Use Back Side)

Well No.

Mail this copy to Board of Water Commissioners 429 Miss. St. Jackson, Miss.