

CLARKE
L32
12-27-63

MISSISSIPPI BOARD OF WATER COMMISSIONERS

CODED

WATER WELL DRILLERS LOG

Driller: **McDONALD & HILL, Inc.**

Date: **12-27, 1963**

P. O. Box #1
MERIDIAN, MISSISSIPPI

Clarke
Lambert

(1) Owner of Land: **P. S. Walker**
(Name)
Rt #1 Collinsville
(Address)

(2) Location: $\frac{1}{4}$, $\frac{1}{4}$, Sec. **21** T. **48** R. **1**
3 miles **SE** of **Pachuta**
(distance) (direction) (Nearest Town)

(3) Topography: **Level**
(Hilly) (Flat) (Level)

(4) Purpose of Well: **Domestic**
(Domestic Irrigation Municipal, Industrial, Other)

Description & Color of Materials Sand, Clay, Red Clay, Shell, etc.	Thick- ness Feet	Depth Feet
clay	0	18
sand	18	49
B. shale	49	80
sand	80	115
B. shale	115	130
limer. shale	130	203
sand	203	210
shale	210	215
sand # 12	215	247
shale	247	250
red sand	250	273

CODED

Information upon completion of well:

(1) Diameter **3** inches.

(2) Total Depth **250** feet.

(3) Water Level **90** feet below top of ground.

(4) Cased to **147**, Size **3**


(5) Screen: Size **#12**, Length **5**

(6) Were any formations sealed against pollution?
 yes, no.

If YES depth of formation _____

Why _____

Drillers Remarks: _____

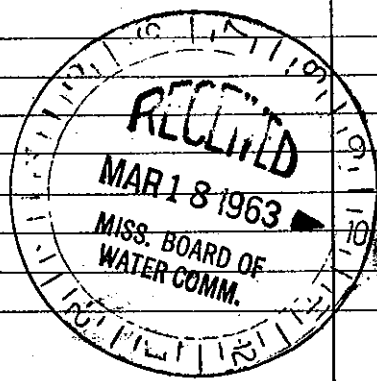

Well No.

(Use Back Side)

Mail this copy to Board of Water Commissioners 429 Miss. St. Jackson, Miss