

STATE WELL REPORT

Part 1

Driller's Log

Mississippi Department of Environmental Quality
Office of Land and Water Resources
P.O. Box 2309
Jackson, MS 39225-2309
(601)961-5210
(601)360-0535 (fax)

For Office Use Only:

Well #: L65
Aquifer: _____
E-Log #: _____

County: Clarke
Permit #: _____
Driller: West Water Well
Date drilling completed: 8-20-14

State Law requires that this report be prepared by the license holder responsible for the work and filed with the Department at the above address within 30 days of completion of drilling of the well or borehole.

<p style="text-align: center;">Well Owner Information <i>(Landowner if borehole is not for a water well)</i></p> <p>Owner Name: <u>Venture Oil & Gas</u> Mailing Address: <u>207 S. 13th Ave</u></p> <p><u>Laurel</u> MS <u>39440</u> City State Zip Code</p> <p>Telephone No. <u>(601) 428-7725</u></p>	<p style="text-align: center;">Well or Borehole Location</p> <p>Latitude: <u>32-01-36</u> Longitude: <u>88-50-21</u> Method of Lat/Long (check one): Conventional Survey _____ USGS quad _____, Hand-held GPS _____, Survey-grade GPS _____</p> <p><u>NE</u> ¼ <u>SW</u> ¼, Sec <u>11</u> T <u>2N</u> R <u>14E</u> <u>2</u> Miles <u>E</u> of <u>Pachuta</u> <i>(Distance) (Direction) (Nearest Town)</i></p>
---	--


<p>Well / Borehole Data</p> <p>Date drilling started: <u>8-20-14</u> Date drilling completed: <u>8-20-14</u> Hole depth: <u>270</u> Hole diameter: <u>6 1/2</u></p> <p>Location of the source of any surface water used for drilling: _____</p> <p>Method of dosing and volume of Chlorine used in drilling and development: _____</p> <p>Logs run (circle all applicable): <u>No log run</u> Electric Gamma Ray Density Sonic Neutron Other: _____</p> <p>Name of organization running log(s): _____</p> <p>Purpose of borehole (circle one): <u>Water Well</u> Geotechnical/Geological Investigation Ground Source Heat Pump Seismic Survey Other (describe) _____</p> <p style="text-align: center;"><i>If drilling is not related to water well construction, skip the remainder of this block</i></p> <p>Purpose of Well (circle all applicable): Home Industrial Public Supply Irrigation Fish Culture Other (describe): <u>Rig Supply</u></p> <p>If a flowing well, method of flow regulation: Valve _____ Other (describe) _____</p> <p>Static Water Level: <u>41</u> feet [above or <u>below</u>] land surface Date measured: <u>8-20-14</u> <i>(circle one)</i></p> <p>Method of measurement (circle one): Steel tape <u>Electric tape</u> Air line Other (describe): _____</p> <p>Well depth: <u>270</u> Well grouted to a depth of: <u>10</u> feet Type of grout (circle one): Neat Cement <u>Bentonite</u> Mix</p> <p>Casing length: <u>230</u> feet Casing diameter: <u>4</u> inches Type of casing: <u>PVC</u></p> <p>Screen length: <u>40</u> feet Screen diameter: <u>4</u> inches Type of screen: <u>PVC slotted</u></p> <p>Screen slot size: <u>.008</u> inches Setting depth: From <u>230</u> feet to <u>270</u> feet</p> <p>Type of completion (circle all applicable): Gravel packed Underreamed Open hole Natural Development Other (describe): _____</p> <p>Top of lap pipe or reduction in casing: _____ feet</p> <p style="text-align: center;"><i>If telescoped or more than one screen, describe on next page</i></p>
--

County: Clarke
Permit #: _____

For Office Use Only:
Well #: L65

The sketch below only required for water wells
If well telescopes, show depths on sketch.

Ground Level

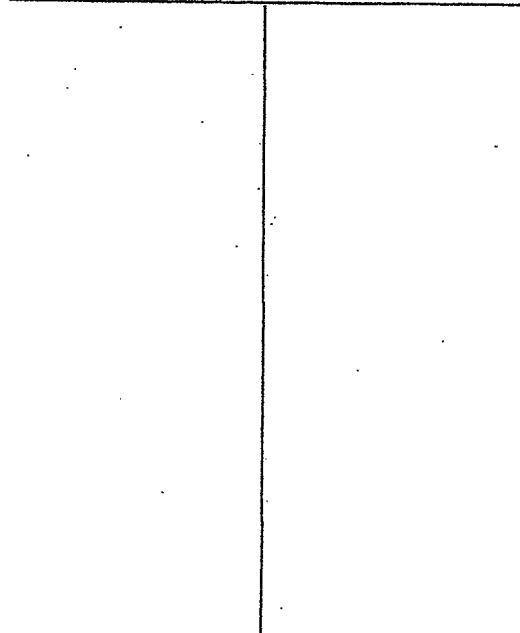


Description of formations encountered must be provided for all wells and boreholes, unless specifically exempted by regulations

Description of Formations Encountered	From (depth)	To (depth)
SOFT CLAY	Ground level	45
SANDY	45	63
SANDY CLAY	63	194
Fine SAND	194	231
Medi. SAND	231	270

If more than one screen, show location of each on sketch

Sketch the property layout and include the following:
1) the well location
2) any permanent structures on the property that may aid in locating the well
3) any roads, power lines, or other items that may aid in locating the property and the well
4) north arrow

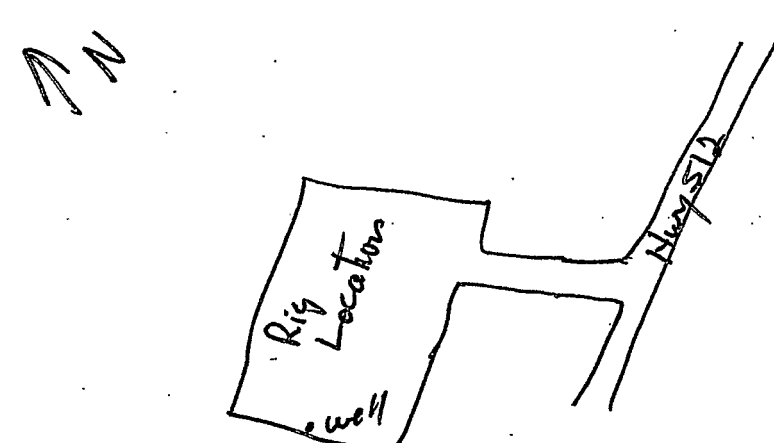

Landowner Name: Ventury Oil & Gas

I HEREBY CERTIFY that the well/borehole was drilled, constructed, and completed in accordance with all applicable requirements of the Mississippi Department of Environmental Quality and the Mississippi Department of Health regulations, if applicable, and state laws.

David A. West 0-672 330-17 David West
Print Name of Responsible Licensee and License No. Date Signature of Licensee

STATE WELL REPORT

Part 2

Pump Installer's Completion Report
 Mississippi Department of Environmental Quality
 Office of Land and Water Resources
 P.O. Box 2309
 Jackson, MS 39225-2309
 (601)961-5210
 (601) 360-0535 (fax)

County: Clarke
 Permit #: _____
 Driller: West Water Well
 Date completed: 8-20-19
Copy information from block on Part 1

For Office Use Only:

Well #: L65
 Aquifer: _____

This part of the report must be completed by a licensed water well contractor or a licensed pump installer. A copy of Part 1 of the report must be attached and both parts filed with the Department at the above address within 30 days of well completion.

Well Owner Information	Well Location
Owner Name: <u>Venture Oil & Gas</u>	Latitude: <u>32-01-36</u> Longitude: <u>88-50-21</u>
Mailing Address: <u>207 S 13th Ave</u>	Method of Lat/Long (check one): Conventional Survey _____, USGS quad _____, Hand-held GPS _____, Survey-grade GPS _____
<u>Laurel</u> <u>MS</u> <u>39440</u>	<u>NE</u> ¼ <u>SW</u> ¼, Sec <u>11</u> T <u>2N</u> R <u>14E</u>
City State Zip Code	<u>2</u> Miles <u>E</u> of <u>Pachuta</u>
Telephone No. <u>(601) 428-7725</u>	(Distance) (Direction) (Nearest Town)

Pump Type (circle one)

Submersible Turbine Air Lift Centrifugal Flowing Well Jet Piston Rotary Other (describe): _____

Date Pump Installed: 8-20-19 Rated Pump Capacity: 50 Gallons Per Minute

Is This Pump (circle one): New Repaired Replacement Rental

Power Type (circle one)

Electric Diesel Gasoline Natural Gas Tractor PTO Windmill Other (describe): _____

Horse Power Rating of Motor: 5 Setting Depth: 140 feet Number of Stages: _____

Pump Test Data for Non Flowing Well

Date Well Tested: _____ Duration of Pump Test (minimum 4 hours): _____ hours

Static Water Level (A): _____ Feet Below Land Surface Pumping Water Level (B): _____ Feet Below Land Surface

Drawdown [(B) - (A)]: _____ Feet Below Land Surface Test Pumping Rate: _____ Gallons Per Minute

Method of measurement (circle one): Steel tape Electric tape Air line Other (describe): _____

Pump Test Data for Flowing Well

Measured shut in head: _____ feet.

Well yielded _____ GPM with a drawdown of _____ feet after _____ hours of pumping

Meter Installation

Meter Manufacturer: _____ Meter Serial Number: _____

Meter Model Number/Name: _____ Type of Meter: _____

Totalizer Register Unit and Multiplier Factor (AF x .001, gal x 1000, etc): _____

Installation Date: _____ Meter installed by: _____

Is This Meter (circle one): New Repaired Replacement

Important: By submitting the above information you are certifying that this meter was installed to manufacturer standards. For agricultural wells, a list of approved meters is on the MDEQ website.

I HEREBY CERTIFY that the above statements are true to the best of my knowledge.

David A. West 0-672 3-30-17 David A. West
 Print Name of Pump Installer and License No. (if applicable) Date Signature of Pump Installer